

MISSISSIPPI DEPARTMENT OF NATURAL RESOURCES

BUD PENNINGTON & SON  
 WATER WELL SERVICE  
 ROUTE 3 BOX 41  
 CARRIERE, MS 39426  
 PHONE 798-5324

Land and Water Resources  
 Southport Mall  
 P.O. Box 10631  
 Jackson, Mississippi 39209

BUD PENNINGTON & SON  
 WATER WELL SERVICE  
 ROUTE 3 BOX 41  
 CARRIERE, MS 39426  
 PHONE 798-5324

Pearl River  
 X 158  
 9-18-81

9/18 1981  
 date well completed

WATERWELL & DRILLERS LOG  
 WATER WELL SERVICE  
 ROUTE 3 BOX 41  
 CARRIERE, MS 39426  
 PHONE 798-5324

CODED  
 Pearl River  
 county well located

LANDOWNER: Robert Vaughn  
 PO Box Pacyons  
 miss.  
 (mailing address)

WELL LOCATION:  
 sec. 3 T-6 R-16  
 3 miles W.S. of Nacogdoches  
 (distance) (direction) (nearest town)

WELL PURPOSE: home  
 (home, irrigation, municipal, industrial)

- WELL COMPLETION DATA:
- (1) diameter (inches) 2"
  - (2) total depth (feet) 1165
  - (3) static water level (feet) 14 below top of ground.
  - (4) casing galv. 1165 (material) (depth)
  - (size) if telescope see back.
  - (5) screen 2x20 1145 (length) (depth to top)
  - 15" 1/2" steel (size) (material)
  - (6) pump no (HP) (yield gpm)
  - (type power)
  - (7) electric log no (yes or no)
  - (organization running log)
  - (8) how well bottom plugged

description of formations encountered	from	to
white shale	0	65
white sand	65	85
blue shale	85	420
blue sand	420	580
blue shale	580	975
blue sand	975	1050
blue shale	1050	1100
dry sand	1100	1165

CODED

DEPT. OF NATURAL RESOURCES  
 BUREAU OF LAND & WATER RESOURCES


SEP 29 1981

RECEIVED

DRILLERS REMARKS: *Shark*

If well telescopes please sketch and show depths.

GROUND LEVEL

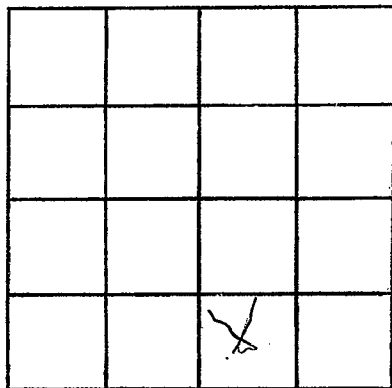

SECTION \_\_\_\_\_

Please indicate well location X.

ADDITIONAL INFORMATION

If more than one screen,  
show locations of each on sketch.