

X159

CODED

10-21-65

WATER WELL DRILLERS LOG

Date: 10-21, 1965, Driller: Neil Lumpkin, County P. R.
(Name)

(1) Owner of Land: Nathan Farmer Jr.
(Name)
Picayune Route
(Address)

(2) Location: 16W 1/4, 1/4, Sec. 18 T16R17
2.8 miles South of Palestine Church
(distance) (direction) (Nearest Town)

(3) Topography: Flat
(Hilly) (Flat) (Level)

(4) Purpose of Well: Domestic
(Domestic Irrigation Municipal, Industrial, Other)

Description & Color of Materials Sand, Clay, Red Clay, Shell, etc.	Thick-ness Feet	Depth Feet
Clay	0	10
Sand & gravel	10	80
Blue clay	80	285
sand	285	520
Clay	520	745
Sand	745	910
blue clay	910	1020
good sand	1020	1113

Information upon completion of well:

(1) Diameter 2 inches.

(2) Total Depth 1113 feet.

(3) Water Level _____ feet below top of ground.

(4) Cased to _____, Size _____.

(5) Screen: Size 2" Length 20'
15 gauge


(6) Were any formations sealed against pollution?
No. no.

If YES depth of formation _____

Why _____

Drillers Remarks: Good well

CODED

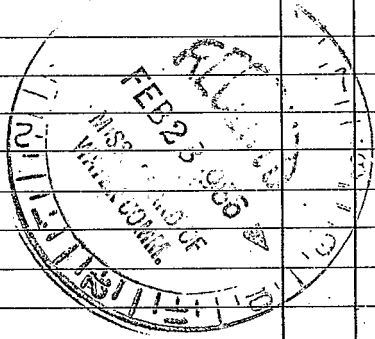

Well No.

(Use Back Side)

