

MISSISSIPPI DEPARTMENT OF ENVIRONMENTAL QUALITY
Bureau of Land and Water Resources

P. O. Box 10631
Jackson, MS 39289-0631
WATER WELL DRILLERS LOG

COUNTY WELL LOCATED Pearl River		
WELL NUMBER X 161	CODED <input checked="" type="checkbox"/>	PERMIT NUMBER
DATE WELL COMPLETED 01-23-97		NAME OF DRILLING FIRM Griner Drilling Service, Inc.

NAME & MAILING ADDRESS OF LANDOWNER Center Water Association		
P.O. Box 299		
Picayune MS 39466		
WELL LOCATION: SEC	TOWNSHIP	RANGE
20	06	16
DISTANCE DIRECTION NEAREST TOWN		
3 Miles	WNW of	intersection
OTHER LANDMARK of I-59 & Hwy. 43S on Beaver Wood Rd.		
WELL PURPOSE: Home, Irrigation, Municipal, Industrial, Fish Pond, etc. municipal		

PUMP DATA		
PUMP TYPE (Circle One): Submersible, <input checked="" type="checkbox"/> Turbine Jet Flowing Well, Other (Describe) _____		
POWER TYPE (Circle One): <input checked="" type="checkbox"/> Electric, Tractor, Diesel, Gasoline, Butane, Other (Describe) _____ H/P _____		
Pump Capacity (GPM)	No. of Stages	Setting Depth
350	9	91 FT.
PUMP TEST		
Well yielded 350 GPM with		
drawdown of 10 ft.		
after 24 hours of pumping		

WELL DATA		
Well Depth 995	Casing Diameter (In.) 12"	Casing Length (Ft.) 925'
Type of Casing steel	Hole Depth 1124'	Depth to Static Water Level 22'
TYPE OF COMPLETION: (Circle One or More): <input checked="" type="checkbox"/> Gravel Packed, Underreamed, Telescoped, <input type="checkbox"/> Natural Development, Open-Hole, Other (Describe) _____		
Top of Lap Pipe or Reduction in Casing 865 FEET IF TELESCOPED OR MORE THAN ONE SCREEN: USE BACK PAGE		

LOG DATA	
TYPE OF LOG RUN (Circle One): <input checked="" type="checkbox"/> Electric, Gamma Ray, Density, Sonic, Neutron, Other (Describe) _____ No Log Run	
Name of Organization Running Log	

SCREEN DATA		
Diameter - Inches 8"	Length - Feet 60'	Slot Size - Inches 0.016
Screen Type rod base	Depth to Bottom - Feet 995	

GEOLOGIC DATA (Office Use Only)			
Surface Elev.	Geologic Unit	Unit Thickness	Depth to Top
Subs. SWL	Date	Analysis	Aquifer Test

Driller's Remarks

RECEIVED


DESCRIPTION OF FORMATIONS ENCOUNTERED	FROM	TO	FORMATIONS (Continued)	FROM	TO
Sand	0	143			
Clay	143	192			
Sand	192	347			
Clay	347	521			
Sand	521	637			
Clay	637	729			
Sand	729	783			
Clay	783	879			
Sand	879	1029			
Clay	1029	1124			
IF MORE SPACE IS NEEDED, USE BACK					

JAN 29 1997

Dept. of Environmental Quality
Office of Land & Water Resources

If well telescopes please
sketch and show depths.

GROUND LEVEL

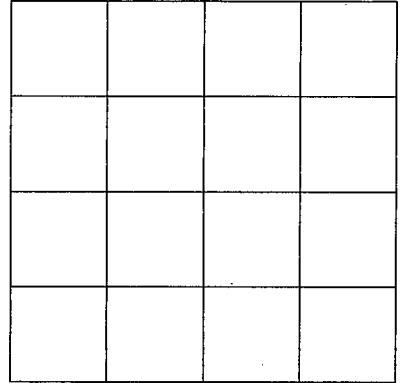

SECTION _____

Please indicate well location X.

ADDITIONAL INFORMATION

If more than one screen,
show location of each on sketch.