


If well telescopes please sketch and show depths.

Good River

Clear water

11/10/12

GROUND LEVEL

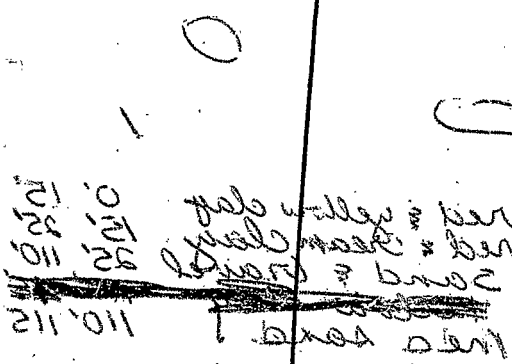

SECTION

Please indicate well location X.

Pump Capacity (GPM) 102	No. of Stages 8	Setting Depth 112 FT.
PUMP TEST		
Well yielded	112	GPM with
a drawdown of		ft.
after	10	hours of pumping

LOG DATA

TYPE OF LOG RUN (Circle One):
 Electric, Gamma Ray, Density, Sonic, Neutron, No Log Run.
 Other (Describe) _____

Name of Organization Running Log
 GPC

GEOLOGIC DATA (Office Use Only)

Surface Elev.	Geologic Unit	Unit Thickness	Depth to Top
Subs. SWL	Date	Analysis	Aquifer Test

Driller's Remarks

[Handwritten signature]

If more than one screen, show location of each on sketch.

11/10/12