

County: Pearl River
 Permit #: _____
 Driller: Reece Penton
 Date drilling completed: 6-13-06

State Well Report
Part 1 - Driller's Log

Mississippi Department of Environmental Quality
 Office of Land and Water Resources
 P.O. Box 10631
 Jackson, MS 39289-0631
 (601)961-5210
 (601)354-6938 (fax)

For Office Use Only:
 Aquifer: _____
 Well #: X-175
 L. S. Elevation: _____
 E-log #: _____

State Law requires that this report be prepared by the license holder responsible for the work and filed with the Department at the above address within 30 days of completion of drilling of the well or borehole.

Information on Well Owner (Landowner if borehole is not for a water well)	Well or Borehole Location
Owner Name: <u>Ricky Boudin</u>	Latitude: _____ Longitude: _____
Mailing Address: _____	Method of Lat/Long (circle one): Conventional Survey, USGS quad, Hand-held GPS, Survey-grade GPS
City: _____ State: _____ Zip Code: _____	_____ 1/4 _____ 1/4 Sec <u>17</u> Twn <u>6S</u> Rng <u>16W</u>
Telephone No. (____) _____	Distance _____ Direction _____ Nearest Town _____ <u>1</u> Miles <u>E</u> of <u>Picayune</u>

Well / Borehole Data

Date drilling started: 6-13-06 Date drilling completed: 6-13-06 Hole depth: 295 Hole diameter: 7

Location of the source of any surface water used for drilling: Personal Water Well
 Method of dosing and volume of Chlorine used in drilling and development: _____

Logs run (circle all applicable): No log run Electric Gamma Ray Density Sonic Neutron Other: _____
 Name of organization running log(s): _____

Purpose of borehole (check one): Water Well Geotechnical/Geological Investigation _____ Ground Source Heat Pump _____
 Seismic Survey _____ Other (describe) _____
If drilling is not related to water well construction, skip the remainder of this block.

Purpose of Well (check one): Home Industrial _____ Public Supply _____ Irrigation _____ Fish Culture _____ Other: _____

If a flowing well, method of flow regulation: Valve _____ Other (describe) _____

Static Water Level: 46 feet above or below (circle one) land surface Date measured: 6-13-06

Method of Measurement (circle one) steel tape electric tape air line other: _____

Well depth: 295 Well grouted to a depth of 10 feet Type of grout (circle one) Neat Cement Bentonite Mix

Casing length: 285 feet Casing diameter: 4 inches Type of casing: PVC

Screen length: 10 feet Screen diameter: 2 inches Type of screen: PVC

Screen slot size: .008 inches Setting depth: From 285 feet to 295 feet

Type of completion (circle all applicable): Gravel packed Underreamed Telescoped Open hole Natural Development
 Other (describe): _____

Top of lap pipe or reduction in casing: _____ feet. *If telescoped or more than one screen, describe on next page*

RECEIVED
JUN 30 2006
BY: OLWR

STATE WELL REPORT

Part 2

Pump Installer's Completion Report
 Mississippi Department of Environmental Quality
 Office of Land and Water Resources
 P.O. Box 10631
 Jackson, MS 39289-0631
 (601)961-5210
 (601)354-6938 (fax)

County: Pearl River
 Permit #: _____
 Driller: Reece Penton
 Date completed: 6-13-06
Copy information from block on Part 1

For Office Use Only:

Aquifer: _____
 Well #: X-175
 Elevation: _____

This part of the report must be completed by a licensed water well contractor or a licensed pump installer. A copy of Part 1 of the report must be attached and both parts filed with the Department at the above address within 30 days of well completion.

Well Owner Information	Well Location
Owner Name: <u>Ricky Boudin</u>	Latitude: _____ Longitude: _____
Mailing Address: <u>2809 Mary Dr</u>	Method of Lat/Long (check one): Conventional Survey _____
<u>Slide 11 La</u>	USGS quad _____, Hand-held GPS _____, Survey-grade GPS _____
City State Zip Code,	_____ 1/4 _____ 1/4 Sec _____ T _____ R _____
Telephone No. <u>(985) 646-</u>	Distance Direction Nearest Town
	_____ Miles _____ of _____

Pump Type Circle one	Power Type Circle one
Air Lift Jet <input type="radio"/> <u>Submersible</u>	Diesel Engine Gasoline Engine Natural Gas
Bucket Piston Turbine	<u>Electric Motor</u> Hand Tractor PTO
Centrifugal Rotary Flowing Well	Windmill Other (specify): _____
Other (specify): _____	Horse Power Rating of Motor: <u>1/2</u>
Date Pump Installed: <u>6-14-06</u>	Setting Depth: <u>70</u>
Rated Pump Capacity: <u>15</u> Gallons Per Minute	Number of Stages: <u>8</u>

RECEIVED
 JUN 30 2006
 BY: OLWR

Pump Test Data	Method of Measuring Water Level Circle one
Date Well Tested: <u>6-14-06</u>	Air Line Electric Measuring Line <u>Steel Tape</u>
Static Water Level (A): <u>46</u> Feet Below Land Surface	Other (specify): _____
Pumping Water Level (B): <u>46</u> Feet Below Land Surface	For flowing well, measured shut in head: _____ feet
Drawdown [(B) - (A)]: <u>2</u> Feet Below Land Surface	Well yielded <u>15</u> GPM with a drawdown of
Test Pumping Rate: <u>15</u> Gallons Per Minute	<u>2</u> feet after <u>12</u> hours of pumping
Duration of Pump Test (minimum 4 hours): <u>12</u> hours	


I HEREBY CERTIFY that the above statements are true to the best of my knowledge.

Reece Penton _____
 Print Name of Pump Installer and License No. (if applicable) Signature of Pump Installer

The sketch below only required for water wells

If well telescopes, show depths on sketch

Ground Level →

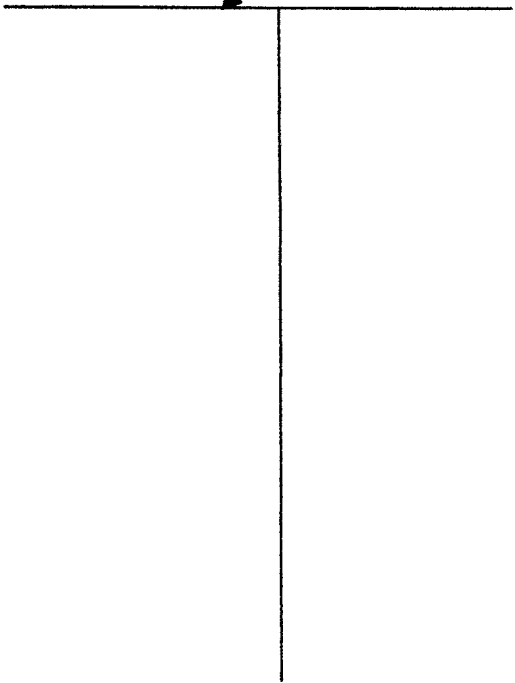


Description of formations encountered must be provided for all wells and boreholes, unless specifically exempted by regulations

Description of Formations Encountered	From (depth)	To (depth)
CLAY	Ground Level	
SAND	0	10
CLAY	10	40
SAND	40	225
	225	225

If more than one screen, show location of each on sketch

Sketch the property layout and include the following: 1) the well location; 2) any permanent structures on the property that may aid in locating the well; 3) any roads, power lines, or other items that may aid in locating the property and the well; 4) a north arrow.

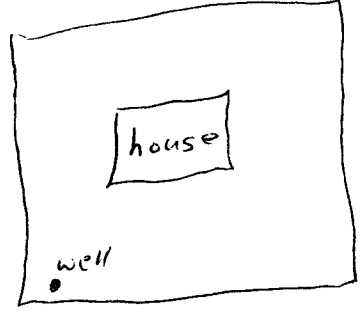

RECEIVED
JUN 30 2006
BY: OLWR

Landowner Name: Ricky Boudin

Form: OLWR-SWR-1A

I certify that the well/borehole was drilled, constructed, and completed in accordance with all applicable requirements of the Mississippi Department of Environmental Quality and the Mississippi Department of Health regulations, if applicable, and state laws.

Reece Penton 0-561 6-25-06 Reece Penton
 Print Name of Responsible Licensee and License No. Date Signature of Licensee