

Pearl River
X 2001

6-66

MISSISSIPPI BOARD OF WATER COMMISSIONERS

WATER WELL DRILLERS LOG

Date: 6-21, 1966, Driller: NEIL HUMPKIN County PEARL RIVER
(When well drilled) (Name) (Where well is located)

(1) Owner of Land:	Description & Color of Materials Sand, Clay, Red Clay, Shell, etc.	Thick- ness Feet	Depth Feet
<u>Mitchell Stockstill</u> (Name) <u>Picayune Rd (Salem)</u> (Address)	<u>Surface clay</u>	<u>0</u>	<u>10</u>
<u>6 16</u> (2) Location: <u>SE 1/4, NW 1/4, Sec. 5 T.5 R.W.</u>	<u>" sand</u>	<u>10</u>	<u>48</u>
<u>3</u> miles <u>East</u> , of <u>Picayune</u> (distance) (direction) (Nearest Town)			
(3) Topography: <u>Flat</u> (Hilly) (Flat) (Level)			
(4) Purpose of Well: <u>Domestic</u> (Domestic Irrigation Municipal, Industrial, Other)			

Information upon completion of well:

(1) Diameter 2 inches.

(2) Total Depth 43 feet.

(3) Water Level 20 feet below top of ground.

(4) Cased to 38, Size 2"

(5) Screen: Size 2", Length 5'

(6) Were any formations sealed against pollution?
 yes, no:


YES depth of formation _____
 Why _____

Drillers Remarks: _____

Yield in gpm: 350 per hr.

Size pump: 1/2 H Sta. Rite

Type power: REA

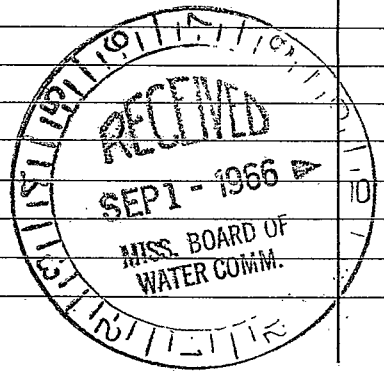

Mail this copy to Board of Water Commissioners 429 Miss. St. Jackson, Miss.

