

X 2002
10-66

WATER WELL DRILLERS LOG

Date: 10-8, 1966, Driller: Walter Penitoni County Pearl River
(Name)

(1) Owner of Land: Andel Stewart
(Name)
Rt 3 Poyune Miss
(Address)

(2) Location: NW 1/4, NE 1/4, Sec. 9 T6 R16
3 1/2 miles NE of Poyune
(distance) (direction) (Nearest Town)

(3) Topography: Flat
(Hilly) (Flat) (Level)

(4) Purpose of Well: Domestic
(Domestic Irrigation
Municipal, Industrial, Other)

Description & Color of Materials Sand, Clay, Red Clay, Shell, etc.	Thick- ness Feet	Depth Feet
Clay	14	0-14
Sand	12	26
Mixed sand + Clay	62	88
Blue Clay	102	190
Yellow Sand	22	212
Blue Clay	114	326
Soft Mud	23	349
Blue Clay	198	547
Grey Sand		580

Information upon completion of well:

(1) Diameter 2 inches.

(2) Total Depth 580 feet.

(3) Water Level 13 feet below top of ground.


(4) Cased to 575, Size 2"

(5) Screen: Size 2" 1012, Length 5'

(6) Were any formations sealed against pollution?
_____ yes, _____ no.

If YES depth of formation _____
Why _____

Drillers Remarks:
Did not Bottom sand
at 580

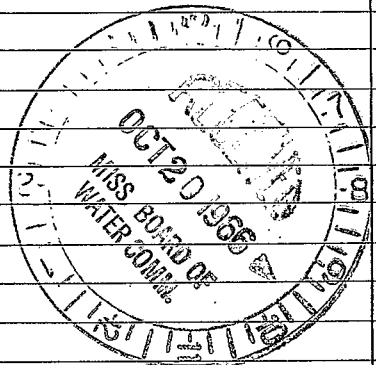

(Use Back Side)

Well No.

