

Pearl River
 X 2003
 10-66

MISSISSIPPI BOARD OF WATER COMMISSIONERS

WATER WELL DRILLERS LOG

Date: 10-15, 1966, Driller: Walter Penton County Pearl River
 (Name)


	Description & Color of Materials Sand, Clay, Red Clay, Shell, etc.	Thick- ness Feet	Depth Feet
(1) Owner of Land: <u>NORMAN Lee</u> (Name) <u>Rt. 3 Picayune Miss</u> (Address)	Clay	17	0-17
(2) Location: <u>SE 1/4, NE 1/4, Sec. 9 T6 R16 W</u> <u>3 1/2</u> miles <u>N-E</u> of <u>Picayune</u> (distance) (direction) (Nearest Town)	Sandy clay	42	59
(3) Topography: <u>Flat</u> (Hilly) (Flat) (Level)	Sand	86	145
(4) Purpose of Well: <u>Domestic</u> (Domestic Irrigation Municipal, Industrial, Other)	Blue Clay	40	185
	Grey sand	25	210

Information upon completion of well:

- (1) Diameter 2 inches.
- (2) Total Depth 210 feet.
- (3) Water Level 17 feet below top of ground.
- (4) Cased to 205, Size 2"
- (5) Screen: Size 2" .012, Length 5'
- (6) Were any formations sealed against pollution?
 yes, no.

If YES depth of formation _____
 Why _____

Drillers Remarks: _____

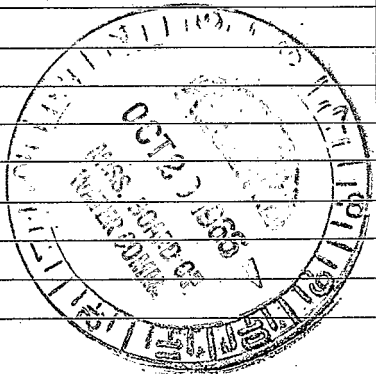

(Use Back Side)

Well No.

