

X 2005

12-66

WATER WELL DRILLERS LOG

Date: 12-13, 1966, Driller: Walter Penton County Pearl River

(Name)

	Description & Color of Materials Sand, Clay, Red Clay, Shell, etc.	Thick- ness Feet	Depth Feet
(1) Owner of Land: <u>Shannon Westbrook</u>	<u>yellow clay</u>	<u>22</u>	<u>0-22</u>
(Name)	<u>sand + gravel</u>	<u>20</u>	<u>42</u>
<u>Rt. 3 Picayune Miss</u>	<u>Brown clay</u>	<u>16</u>	<u>58</u>
(Address)	<u>Blue clay</u>	<u>20</u>	<u>78</u>
(2) Location: <u>NW 1/4, NE 1/4, Sec. 17 T. 6 R. 16, S S</u>	<u>Sand</u>	<u>8</u>	<u>86</u>
<u>1 1/2 miles E.N.E. of Picayune</u>	<u>Blue clay</u>	<u>105</u>	<u>191</u>
(distance) (direction) (Nearest Town)	<u>Brown clay</u>	<u>6</u>	<u>197</u>
(3) Topography: <u>Flat</u>	<u>Blue clay</u>	<u>143</u>	<u>340</u>
(Hilly) (Flat) (Level)	<u>Grey sand</u>	<u>10</u>	<u>350</u>
(4) Purpose of Well: <u>Domestic</u>			
(Domestic Irrigation Municipal, Industrial, Other)			

Information upon completion of well:


- (1) Diameter 4 1/2 inches. Drilled
- (2) Total Depth 350 feet.
- (3) Water Level 50 feet below top of ground.
- (4) Cased to 345, Size 2"
- (5) Screen: Size .010 2", Length 5'
- (6) Were any formations sealed against pollution?

 yes, no.

If YES depth of formation

Why

Drillers Remarks:

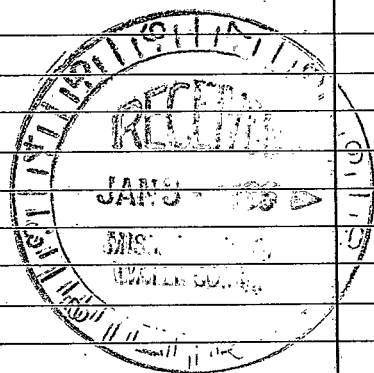

(Use Back Side)

Well No.

