

MISSISSIPPI
 BOARD OF WATER COMMISSIONERS
 416 North State Street
 Jackson, Mississippi 39201

WATER WELL DRILLERS LOG

Pearl River
~~Hancock~~
 county well located

Pearl River
 X 2007
 5-67

5-25
 date well completed

1967 Penlon Well Serv
 firm name

LANDOWNER: Bill Adams

description of formations encountered

from	to
0	36
36	68
68	174
174	210
210	426
426	467

Rh 3

Picayune Miss
 (mailing address)

WELL LOCATION:

sec. 1 T. 6 S. R. 16 W.
 3 miles south of Caesar
 (distance) (direction) (nearest town)

WELL PURPOSE: Home
 (home, irrigation, municipal, industrial)


WELL COMPLETION DATA:

- (1) diameter (inches) 2"
- (2) total depth (feet) 467
- (3) static water level (feet) 47 below top of ground.
- (4) casing Galv. steel 462 (material) (depth)
 2" (size) if telescope see back.
- (5) screen 5' 462 (length) (depth to top)
 2" S. Steel (size) (material)
- (6) pump 1 520 (HP) (yield gpm)
 Elec (type power)
- (7) electric log NO (yes or no)

(organization running log)


(8) how well bottom plugged Bw. Valve

DRILLERS REMARKS:

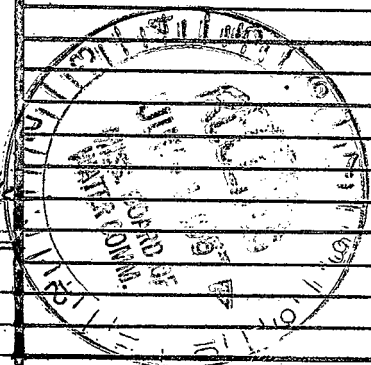

If well telescopes please sketch and show depths.

GROUND LEVEL

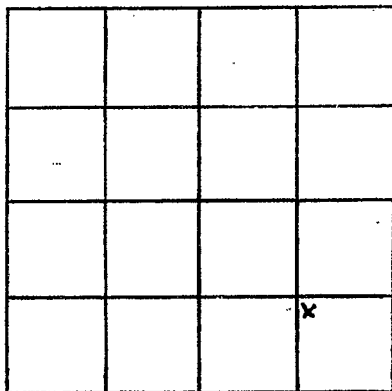

SECTION 1

Please indicate well location X.

ADDITIONAL INFORMATION

If more than one screen, show locations of each on sketch.