

Pearl River
 X 2008
 5-67

MISSISSIPPI
 BOARD OF WATER COMMISSIONERS
 416 North State Street
 Jackson, Mississippi 39201

WATER WELL DRILLERS LOG

5-29 1967 Penton Well Serv Pearl River
 date well completed firm name county well located

LANDOWNER: James Davis
 Rt. 3 New No Box
 Picayune Miss
 (mailing address)


description of formations encountered	from	to
Red Clay	0	24
Sand	24	56
Blue Clay	56	162
Grey Sand	162	188

WELL LOCATION:
 sec. 4 T. 6 S. R. 16 W.
 4 miles NE of Picayune
 (distance) (direction) (nearest town)

WELL PURPOSE: Home
 (home, irrigation, municipal, industrial)

WELL COMPLETION DATA:


- (1) diameter (inches) 4 1/2 Drilled
- (2) total depth (feet) 188
- (3) static water level (feet) 22' below top of ground.
- (4) casing Galv. Steel, 183'
 (material) (depth)
3" if telescope see back.
 (size)
- (5) screen 5', 183'
 (length) (depth to top)
 .012 2", S. Steel
 (size) (material)
- (6) pump _____ (HP) _____ (yield gpm)
 _____ (type power)
- (7) electric log No
 (yes or no)
 _____ (organization running log)
- (8) how well bottom plugged Bw. Valve

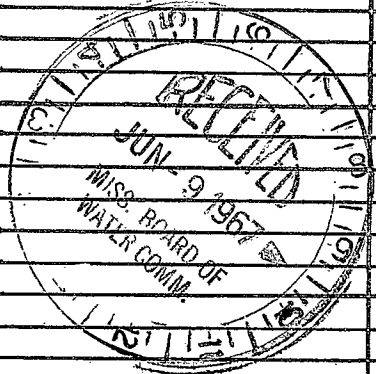

DRILLERS REMARKS: Pumped at about 700 GPH with Air for cleaning only No Pump installed

If well telescopes please sketch and show depths.

GROUND LEVEL

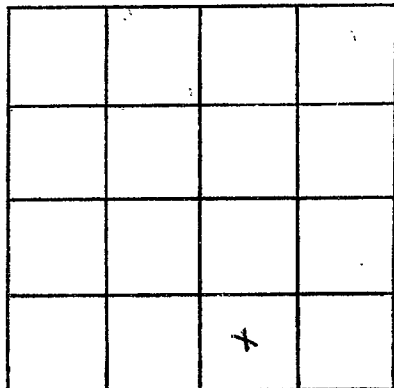

SECTION 4

Please indicate well location X.

ADDITIONAL INFORMATION

If more than one screen,
show locations of each on sketch.