

Pearl River
 A 2007
 5-67

MISSISSIPPI
 BOARD OF WATER COMMISSIONERS
 416 North State Street
 Jackson, Mississippi 39201

WATER WELL DRILLERS LOG

Pearl River

5-31

1967 Periton Well Serv

Hancock

date well completed

firm name

county well located

LANDOWNER: G. E. Allen

Rt 3, Box 365

Picayune Miss
 (mailing address)

description of formations encountered

from

to

Clay

0 36

Sand

36 63

Blue clay

63 172

Grey sand

172 216

WELL LOCATION:

sec. 1 T. 6 S. R. 16 W.
 3 miles South of Caesar
 (distance) (direction) (nearest town)

WELL PURPOSE: Home
 (home, irrigation, municipal, industrial)

WELL COMPLETION DATA:

(1) diameter (inches) 4 1/2 Drilled

(2) total depth (feet) 216

(3) static water level (feet) 44 below top of ground.

(4) casing Galv. Steel 2 1/2
 (material) (depth)

2" if telescope see back.
 (size)

(5) screen 5' 2 1/2
 (length) (depth to top)

0 1/2 2" S. Steel
 (size) (material)

(6) pump 1 8
 (HP) (yield gpm)


Elec.
 (type power)

(7) electric log No
 (yes or no)

(organization running log)

(8) how well bottom plugged BW Valve

DRILLERS REMARKS:

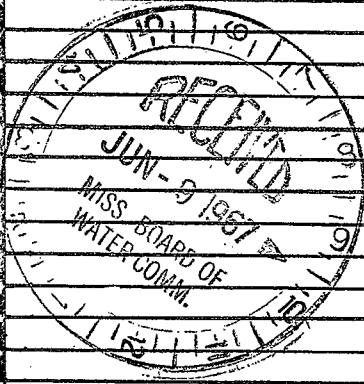

If well telescopes please sketch and show depths.

GROUND LEVEL

			X

SECTION 1

Please indicate well location X.

ADDITIONAL INFORMATION

If more than one screen, show locations of each on sketch.