

Pearl River  
 X 2010  
 10-67

MISSISSIPPI  
 BOARD OF WATER COMMISSIONERS  
 416 North State Street  
 Jackson, Mississippi 39201

WATER WELL DRILLERS LOG

10-12 1967 Ponton Well Serv Pearl River  
 date well completed firm name county well located

LANDOWNER: Johnny Skipper  
 Rh. 3 New - No Box

Picayune Miss  
 (mailing address)

WELL LOCATION:  
 sec. 9 T. 6 S. R. 16 W.  
 3 miles N. E. of Picayune  
 (distance) (direction) (nearest town)

WELL PURPOSE: Home  
 (home, irrigation, municipal, industrial)


WELL COMPLETION DATA:

- (1) diameter (inches) 4 1/2" Drilled
- (2) total depth (feet) 212
- (3) static water level (feet) 23 below  
 top of ground.
- (4) casing Galv. Steel 207,  
 (material) (depth)  
2'  
 (size) if telescope see back.
- (5) screen 5', 207  
 (length) (depth to top)  
012- 2", S. Steel  
 (size) (material)
- (6) pump 1/2 11  
 (HP) (yield gpm)  
Elec  
 (type power)
- (7) electric log No  
 (yes or no)  
 (organization running log)
- (8) how well bottom plugged B.W. Valve

description of formations encountered

from to

yellow clay	0	22
Red sand	22	46
White sand	46	58
White clay	58	67
Blue clay	67	190
Grey sand	190	214

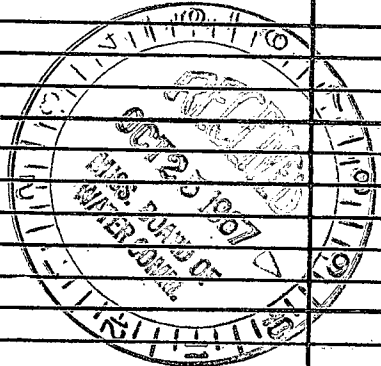

DRILLERS REMARKS:

If well telescopes please sketch and show depths.

GROUND LEVEL

		x	

SECTION 9

Please indicate well location X.

ADDITIONAL INFORMATION

If more than one screen, show locations of each on sketch.