

Pearl River
 X 2011
 4-68

MISSISSIPPI
 BOARD OF WATER COMMISSIONERS
 416 North State Street
 Jackson, Mississippi 39201

WATER WELL DRILLERS LOG

4-22 1968 Penton Well Serv Pearl River
 date well completed firm name county well located

LANDOWNER: L. C. Burg

Box 102

Picayune MISS
 (mailing address)

description of formations encountered

from

to

Red Clay	0	24
Red sand	24	42
White clay	42	68
Blue clay	68	155
Grey sand	155	183

WELL LOCATION:

sec. 6 T. 6 S. R. 16 W.
 1/2 miles NE of Picayune
 (distance) (direction) (nearest town)

WELL PURPOSE: Home
 (home, irrigation, municipal, industrial)


WELL COMPLETION DATA:

- (1) diameter (inches) 2"
- (2) total depth (feet) 183
- (3) static water level (feet) 36 below top of ground.
- (4) casing Galv. steel 178 (material) (depth)
 2" (size) if telescope see back.
- (5) screen 5' 178 (length) (depth to top)
 2" (size) S. Steel (material)
- (6) pump (HP) (yield gpm)
 Elec (type power)
- (7) electric log NO (yes or no)
 (organization running log)
- (8) how well bottom plugged Bw. Valve

DRILLERS REMARKS:

If well telescopes please
sketch and show depths.

GROUND LEVEL

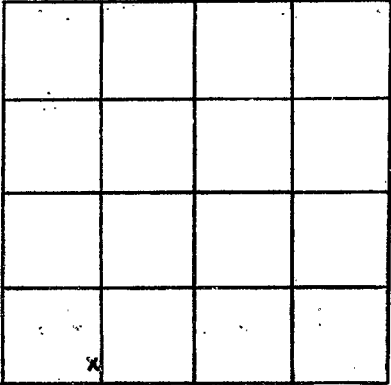

SECTION 6

Please indicate well location X.

ADDITIONAL INFORMATION

If more than one screen,
show locations of each on sketch.