

PEARL RIVER
 X 2012
 5-68

MISSISSIPPI
 BOARD OF WATER COMMISSIONERS
 416 North State Street
 Jackson, Mississippi 39201

WATER WELL DRILLERS LOG

5-13 1968 Ponton Well Serv Pearl River
 date well completed firm name county well located

LANDOWNER: Jerry Bennett

2318 Adcox Rd.

Picayune Miss
 (mailing address)

description of formations encountered

from to

yellow clay
 sand

0 23

23 150

Blue clay

150 196

gray sand

196 204

WELL LOCATION:

sec. 4 T. 6 S. R. 16 W.
 3 miles N. E. of Picayune
 (distance) (direction) (nearest town)

WELL PURPOSE: Home
 (home, irrigation, municipal, industrial)

WELL COMPLETION DATA:

(1) diameter (inches) 2"

(2) total depth (feet) 214'

(3) static water level (feet) 20 below top of ground.

(4) casing Galv., 209'
 (material) (depth)

2" if telescope see back.
 (size)

(5) screen 5', 209'
 (length) (depth to top)

1012- 2" S. steel
 (size) (material)

(6) pump (HP) (yield gpm)

(type power)

(7) electric log NO
 (yes or no)

(organization running log)

(8) how well bottom plugged B.W. Valve


DRILLERS REMARKS: NO Pump

MAY 20 1968

MISS. BD. OF WATER COMM.

If well telescopes please sketch and show depths.

GROUND LEVEL

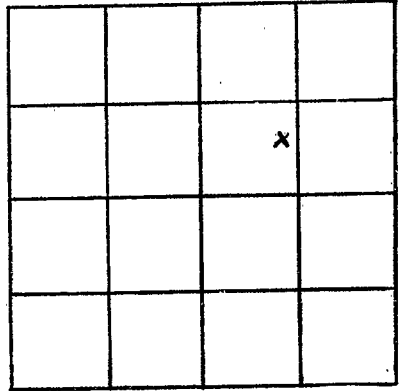

SECTION 4

Please indicate well location X.

ADDITIONAL INFORMATION

If more than one screen,
show locations of each on sketch.