

Pearl River  
X 2013  
11-14-75

MISSISSIPPI  
 BOARD OF WATER COMMISSIONERS  
 416 North State Street  
 Jackson, Mississippi 39201

WATER WELL DRILLERS LOG

11-14 1975 Pentons well Serv Pearl River  
 date well completed firm name county well located


LANDOWNER: <u>Preston Spiers</u>	description of fomations encountered	from	to
<u>Pr. 2</u>			
<u>Carriere MISS.</u> (mailing address)	<u>Surface Clay</u>	<u>0</u>	<u>20</u>
	<u>Sand</u>	<u>20</u>	<u>60</u>
	<u>Blue Clay</u>	<u>60</u>	<u>300</u>
	<u>Sand</u>	<u>300</u>	<u>240</u>
WELL LOCATION:			
sec. <u>6</u> T. <u>6</u> N. R. <u>16</u> E. 13W. S. W.			
<u>1/2</u> miles <u>N.E.</u> of <u>Picayune</u> (distance) (direction) (nearest town)			
WELL PURPOSE: <u>Home</u> (home, irrigation, municipal, industrial)			
WELL COMPLETION DATA:			
(1) diameter (inches) <u>2</u>			
(2) total depth (feet) <u>240</u>			
(3) static water level (feet) <u>44</u> below top of ground.			
(4) casing <u>Galv.</u> , <u>230</u> , (material) (depth)			
<u>2</u> if telescope see back. (size)			
(5) screen <u>10'</u> , <u>230</u> (length) (depth to top)			
<u>2</u> , <u>S. Steel</u> (size) (material)			
(6) pump <u>1</u> , <u>10</u> (HP) (yield gpm)			
<u>Elec</u> (type power)			
(7) electric log <u>No</u> (yes or no)			
(organization running log)			
(8) how well bottom plugged <u>B.W. Valve</u>			
DRILLERS REMARKS:			

INDEXED  
 FILED  
 DEC - 1 1975

MISS. Bd. OF WATER COMMISSIONERS

If well telescopes please sketch and show depths.

GROUND LEVEL

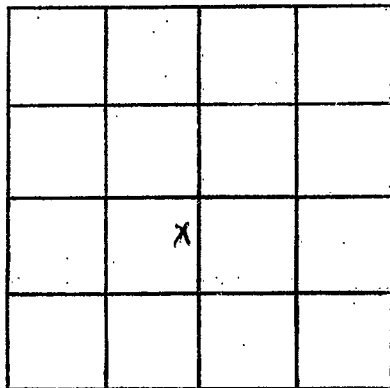

SECTION 6

Please indicate well location X.

ADDITIONAL INFORMATION

If more than one screen, show locations of each on sketch.