

PEARL RIVER
 2014
 11-26-75

MISSISSIPPI
 BOARD OF WATER COMMISSIONERS
 416 North State Street
 Jackson, Mississippi 39201

WATER WELL DRILLERS LOG

11/26 1975 Budget Drilling Pearl River
 date well completed firm name county well located

LANDOWNER: J. H. Moore
Paroyne Miss.
 (mailing address)

description of formations encountered	from	to
Red shale	0	20
Red sand	20	45
Red shale	45	60
Red sand & rock	60	80


WELL LOCATION: 16-16
 sec. 4 T. 6N. R. 13E
6 miles E of Paroyne
 (distance) (direction) (nearest town)

WELL PURPOSE: home
 (home, irrigation, municipal, industrial)

WELL COMPLETION DATA:

- (1) diameter (inches) 2"
- (2) total depth (feet) 80
- (3) static water level (feet) 45 below top of ground.
- (4) casing PVC, 75'
 (material) (depth)
2 if telescope see back.
 (size)
- (5) screen 2x5', 75'
 (length) (depth to top)
2", PVC
 (size) (material)
- (6) pump 1/2 305 59pm
 (HP) (yield gpm)
Elect
 (type power)
- (7) electric log no
 (yes or no)
- (organization running log)
- (8) how well bottom plugged Sand shunt

DRILLERS REMARKS:

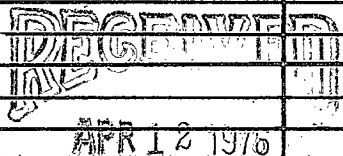

If well telescopes please
sketch and show depths.

GROUND LEVEL

			X

SECTION _____

Please indicate well location X.

ADDITIONAL INFORMATION

If more than one screen,
show locations of each on sketch.