

Pearl River
 X 2015
 1-20-76

MISSISSIPPI
 BOARD OF WATER COMMISSIONERS
 416 North State Street
 Jackson, Mississippi 39201

WATER WELL DRILLERS LOG

1-20 1976 Penton Well Serv Pearl River
 date well completed firm name county well located

LANDOWNER: Peters Bros
Rt. 2
Carriere, Ms.
 (mailing address)

description of fomations encountered	from	to
Surface Clay	0	22
Sand	22	55
Blue Clay	55	200
Sand	200	238

WELL LOCATION:
 sec. 6 T. 6 N R. 16 E
 S W
1/2 miles NE of Picayune
 (distance) (direction) (nearest town)

WELL PURPOSE: Home
 (home, irrigation, municipal, industrial)

- WELL COMPLETION DATA:
- (1) diameter (inches) 2
 - (2) total depth (feet) 238
 - (3) static water level (feet) 45 below top of ground.
 - (4) casing Galv, 238,
 (material) (depth)
2 if telescope see back.
 (size)
 - (5) screen 10', 238
 (length) (depth to top)
2, S. Steel
 (size) (material)
 - (6) pump 1 10
 (HP) (yield gpm)
Elec
 (type power)
 - (7) electric log No
 (yes or no)
 - (8) how well bottom plugged B.W. Value


DRILLERS REMARKS:

RECEIVED
 FEB 17 1976

MISS. BD. OF WATER COMMISSIONERS

If well telescopes please sketch and show depths.

GROUND LEVEL

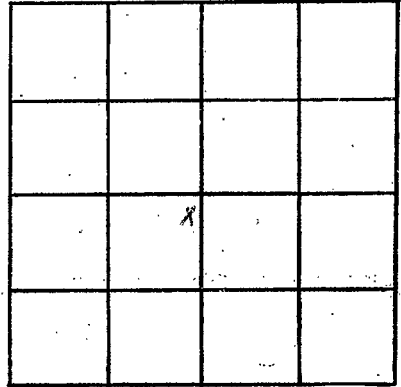

SECTION 6

Please indicate well location X.

ADDITIONAL INFORMATION

Lined area for additional information.

If more than one screen, show locations of each on sketch.