

PEARL RIVER  
X 2016  
1-21-76

MISSISSIPPI  
BOARD OF WATER COMMISSIONERS  
416 North State Street  
Jackson, Mississippi 39201

WATER WELL DRILLERS LOG

1-21 1976 date well completed  
Pearl River Well Serv firm name  
Pearl River county well located


LANDOWNER: <u>Spiers Bros</u>	description of formations encountered	from	to
<u>Rt. 2</u>			
<u>Carriere Ms</u> (mailing address)	<u>Surface Clay</u>	<u>0</u>	<u>20</u>
	<u>Red Sand</u>	<u>20</u>	<u>65</u>
	<u>Blue Clay</u>	<u>65</u>	<u>210</u>
	<u>Sand</u>	<u>210</u>	<u>246</u>
WELL LOCATION:			
sec. <u>6</u> T. <u>6</u> N. R. <u>16</u> E.			
<u>1/2</u> miles <u>NE</u> of <u>Picayune</u>			
(distance) (direction) (nearest town)			
WELL PURPOSE: <u>Home</u> (home, irrigation, municipal, industrial)			
WELL COMPLETION DATA:			
(1) diameter (inches) <u>2</u>			
(2) total depth (feet) <u>246</u>			
(3) static water level (feet) <u>44</u> below top of ground.			
(4) casing <u>Galv.</u> (material) <u>236</u> (depth)			
<u>2</u> (size) if telescope see back.			
(5) screen <u>10'</u> (length) <u>236</u> (depth to top)			
<u>2</u> (size) <u>S. Steel</u> (material)			
(6) pump <u>1</u> (HP) <u>10</u> (yield gpm)			
<u>Elec</u> (type power)			
(7) electric log <u>NO</u> (yes or no)			
(organization running log)			
(8) how well bottom plugged <u>BW Valve</u>			
DRILLERS REMARKS:			

RECEIVED  
FEB 17 1976

MISS. BD. OF V.

If well telescopes please  
sketch and show depths.

GROUND LEVEL

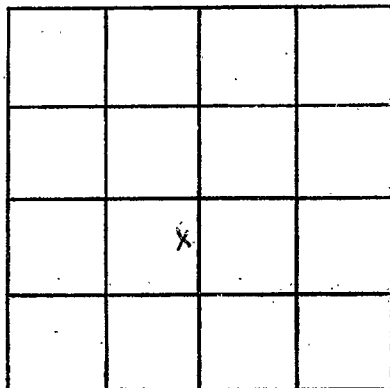

SECTION 6

Please indicate well location X.

ADDITIONAL INFORMATION

If more than one screen,  
show locations of each on sketch.