

PEARL RIVER
X 2018
4-22-76

MISSISSIPPI
 BOARD OF WATER COMMISSIONERS
 416 North State Street
 Jackson, Mississippi 39201

WATER WELL DRILLERS LOG

4-22 1976 Pantone Well Serv Pearl River
 date well completed firm name county well located

LANDOWNER: Spiers Bros -
Rt. 2
Carriere, MS -
 (mailing address)


description of formations encountered	from	to
Surface clay	0	20
Sand	20	45
Blue clay	45	270
Sand	270	290

WELL LOCATION:
 6 sec. B T 6 N R 16 E
 S W
1/2 miles East of Acaryune
 (distance) (direction) (nearest town)

WELL PURPOSE: Home
 (home, irrigation, municipal, industrial)


- WELL COMPLETION DATA:
- (1) diameter (inches) 2
 - (2) total depth (feet) 290
 - (3) static water level (feet) 43 below
top of ground.
 - (4) casing Galv., 280,
(material) (depth)
2 if telescope see back.
(size)
 - (5) screen 10', 280
(length) (depth to top)
2, S. Steel
(size) (material)
 - (6) pump 1 10
(HP) (yield gpm)
Elec
(type power)
 - (7) electric log no
(yes or no)
 - (organization running log)
 - (8) how well bottom plugged B.W. Valve

DRILLERS REMARKS:

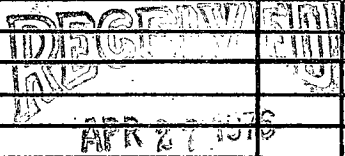

If well telescopes please
sketch and show depths.

GROUND LEVEL

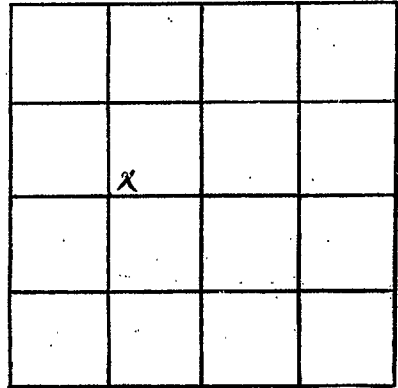

SECTION 6

Please indicate well location X.

ADDITIONAL INFORMATION

If more than one screen,
show locations of each on sketch.