

PEARL RIVER
X 2020
4/76

MISSISSIPPI
 BOARD OF WATER COMMISSIONERS
 416 North State Street
 Jackson, Mississippi 39201

WATER WELL DRILLERS LOG

APRIL
 date well completed

1976 Penton Well Serv Pearl River
 firm name county well located

LANDOWNER: Spiers Bros.

description of formations encountered

from to

Rt. 2

Surface Clay

0 20

Carriere, MS-
 (mailing address)

Sand

20 40

Blue Clay

40 160

Sand

160 181

WELL LOCATION:

sec. 7 T. 6 N R. 16 E
 S W
1/2 miles East of Picayune
 (distance) (direction) (nearest town)

WELL PURPOSE:

(home, irrigation, municipal, industrial)

WELL COMPLETION DATA:

- (1) diameter (inches) 2
- (2) total depth (feet) 181
- (3) static water level (feet) 32 below
 top of ground.
- (4) casing Galv. 171
 (material) (depth)
- 2 If telescope see back.
 (size)
- (5) screen 10' 171
 (length) (depth to top)
- 2 3. Steel
 (size) (material)
- (6) pump 1 10
 (HP) (yield gpm)
- Elec
 (type power)
- (7) electric log No
 (yes or no)

(organization running log)


(8) how well bottom plugged Br. Valve

DRILLERS REMARKS:

RECEIVED
 APR 27 1976

If well telescopes please
sketch and show depths.

GROUND LEVEL

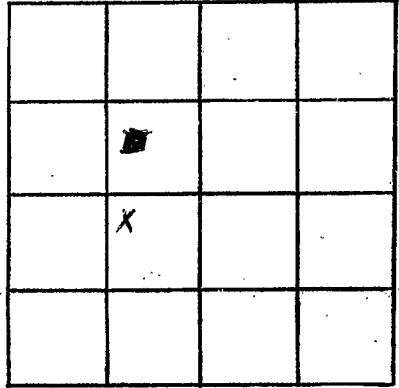

SECTION 7

Please indicate well location X.

ADDITIONAL INFORMATION

If more than one screen,
show locations of each on sketch.