

Pearl River
 X 2023
 7-2-76

MISSISSIPPI
 BOARD OF WATER COMMISSIONERS
 416 North State Street
 Jackson, Mississippi 39201

WATER WELL DRILLERS LOG

7-2 date well completed
 137 76 Periton well Serv firm name
 Pearl River county well located

LANDOWNER: Dale Fleming
 Rt.
 Carriere MS
 (mailing address)

description of formations encountered	from	to
Surface Clay	0	20
Sand	20	45
Blue clay	45	175
Sand	175	207

WELL LOCATION:
 sec. 6 T. 6 N. R. 16 E.
 S W
 1 miles NE of Picayune
 (distance) (direction) (nearest town)

WELL PURPOSE: HOME
 (home, irrigation, municipal, industrial)

- WELL COMPLETION DATA:
- (1) diameter (inches) 2
 - (2) total depth (feet) 207
 - (3) static water level (feet) 39 below top of ground.
 - (4) casing Galv. 197 (material) (depth)
 2 (size) if telescope see back.
 - (5) screen 10' 197 (length) (depth to top)
 2 3. Steel (size) (material)
 - (6) pump 1/2 7 (HP) (yield gpm)
 Elec (type power)
 - (7) electric log NO (yes or no)


(organization running log)
 (8) how well bottom plugged Bill Value

DRILLERS REMARKS:

DECEMBER
 JUL - 8 1976
 MISSISSIPPI BOARD OF WATER COMMISSIONERS

If well telescopes please sketch and show depths.

GROUND LEVEL

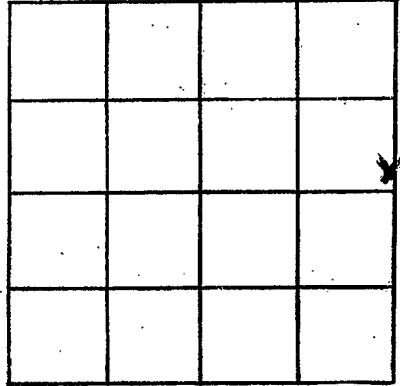

SECTION 6

Please indicate well location X.

ADDITIONAL INFORMATION

If more than one screen,
show locations of each on sketch.