

Pearl River
 7-2004
 7-10-76

MISSISSIPPI
 BOARD OF WATER COMMISSIONERS
 416 North State Street
 138 Jackson, Mississippi 39201

WATER WELL DRILLERS LOG

7-10 1976 Bud Penton & Son Pearl River
 date well completed firm name county well located

LANDOWNER: Greg Mitchell
Decatur, Mo.
 (mailing address)

description of formations encountered	from	to
<u>Red shale</u>	<u>0</u>	<u>21</u>
<u>white sand</u>	<u>21</u>	<u>65</u>
<u>Blue shale</u>	<u>65</u>	<u>56</u>
<u>gray sand</u>	<u>56</u>	<u>620</u>

WELL LOCATION:
 sec 10 T 60 N R 16 E
6 miles East of Decatur
 (distance) (direction) (nearest town)

WELL PURPOSE: Home
 (home, irrigation, municipal, industrial)

- WELL COMPLETION DATA:
- (1) diameter (inches) 4 in
 - (2) total depth (feet) 630
 - (3) static water level (feet) 2 below ~~above~~ top of ground.
 - (4) casing galv, 620
 (material) (depth)
N/A if telescope see back.
 (size)
 - (5) screen 10, 610
 (length) (depth to top)
10, 2 in
 (size) (material)
 - (6) pump 1/2, 1630
 (HP) (yield gpm)
chest
 (type power)
 - (7) electric log _____
 (yes or no)
 - _____ (organization running log)

(8) how well bottom plugged Leak
 DRILLERS REMARKS: Stork


RECEIVED
 SEP - 1 1976

MISS. BB. OF WATER COMM

If well telescopes please sketch and show depths.

GROUND LEVEL

63 ft
14 ft
56 ft

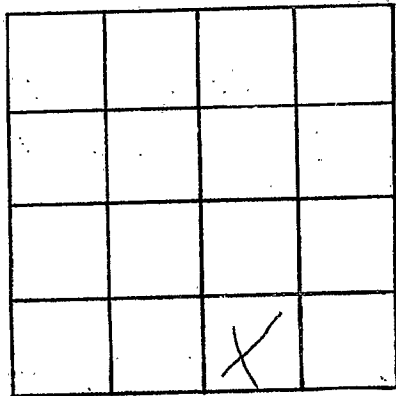

SECTION _____

Please indicate well location X.

ADDITIONAL INFORMATION

If more than one screen, show locations of each on sketch.