

Pearl River  
No. 2025  
10/23/76

MISSISSIPPI  
BOARD OF WATER COMMISSIONERS  
416 North State Street  
Jackson, Mississippi 39201

WATER WELL DRILLERS LOG

10-23 date well completed  
1976 Penitoni Well Serv firm name  
Pearl River county well located

LANDOWNER: H.K. Stockstill  
Rt.  
Picayune MS  
(mailing address)

description of formations encountered	from	to
Surface clay	0	20
SAND	20	40
Blue clay	40	220
Sand	220	246

WELL LOCATION:  
sec. 6 T. 6 N R. 16 E  
S W  
3/4 miles NE of Picayune  
(distance) (direction) (nearest town)

WELL PURPOSE: Home  
(home, irrigation, municipal, industrial)

- WELL COMPLETION DATA:
- (1) diameter (inches) 2
  - (2) total depth (feet) 246
  - (3) static water level (feet) 35 below top of ground.
  - (4) casing Galv. 236 (material) (depth)  
2 (size) if telescope see back.
  - (5) screen 10' 236 (length) (depth to top)  
2 S. Steel (size) (material)
  - (6) pump (HP) (yield gpm)  
(type power)
  - (7) electric log NO (yes or no)

(organization running log)  
(8) how well bottom plugged B.W. Value


DRILLERS REMARKS:

RECEIVED  
NOV 11 1976

MISS. Bd. OF WATER COMMISSIONERS

If well telescopes please sketch and show depths.

GROUND LEVEL

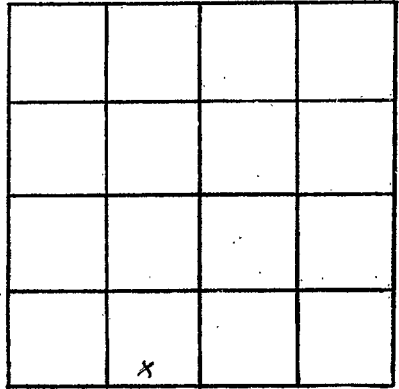

SECTION 6

Please indicate well location X.

ADDITIONAL INFORMATION

If more than one screen, show locations of each on sketch.