

Pearl River
X 2000
2-2-77

MISSISSIPPI
 BOARD OF WATER COMMISSIONERS
 416 North State Street
 Jackson, Mississippi 39201

WATER WELL DRILLERS LOG

2-2 13 ✓ 1977 Perston Well Serv Pearl River
 date well completed firm name county well located

LANDOWNER: L.A. Hooper
Picayune MS.
 (mailing address)
 WELL LOCATION:
 sec. 19 T 6 S R 16 E W
1/2 miles East of Picayune
 (distance) (direction) (nearest town)


description of formations encountered	from	to
Surface Clay	0	15
Sand	15	40
Blue Clay	40	230
Sand	230	265
Blue Clay	265	280
Sand	280	310

WELL PURPOSE: HOME
 (home, irrigation, municipal, industrial)

- WELL COMPLETION DATA:
- (1) diameter (inches) 2
 - (2) total depth (feet) 310
 - (3) static water level (feet) 20 below top of ground.
 - (4) casing Galv. 300
 (material) (depth)
2 if telescope see back.
 (size)
 - (5) screen 10' 300
 (length) (depth to top)
2 S. Steel
 (size) (material)
 - (6) pump 1/2 8
 (HP) (yield gpm)
Elec
 (type power)
 - (7) electric log NO
 (yes or no)

(organization running log)
 (8) how well bottom plugged B.W. Value


DRILLERS REMARKS:

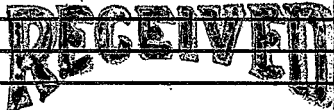

MAR - 4 1977

If well telescopes please sketch and show depths.

GROUND LEVEL

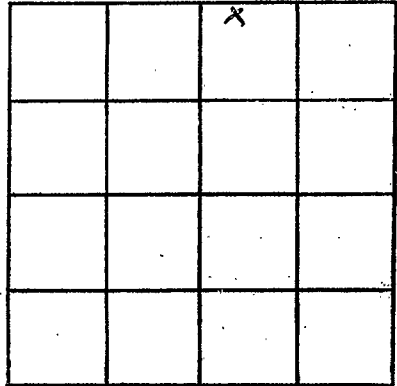

SECTION 19

Please indicate well location X.

ADDITIONAL INFORMATION

If more than one screen, show locations of each on sketch.