

Pearl River
X 20301
2-26-77

MISSISSIPPI
 BOARD OF WATER COMMISSIONERS
 416 North State Street
 Jackson, Mississippi 39201

WATER WELL DRILLERS LOG

2-26 date well completed 137 77 Pantons Well Serv firm name Pearl River county well located


LANDOWNER: <u>Spiero Const</u>	description of formations encountered	from	to
<u>Rt. 2</u>			
<u>Carriere MS-</u> (mailing address)	<u>Sand</u>	<u>15</u>	<u>30</u>
	<u>Blue Clay</u>	<u>20</u>	<u>255</u>
	<u>Fine Sand</u>	<u>255</u>	<u>280</u>
	<u>Blue Clay</u>	<u>280</u>	<u>380</u>
	<u>Sand</u>	<u>380</u>	<u>415</u>
WELL LOCATION: sec. <u>7</u> T. <u>6</u> S. R. <u>16</u> W. <u>1/2</u> miles <u>East</u> of <u>Piquyune</u> (distance) (direction) (nearest town)			
WELL PURPOSE: <u>Home</u> (home, irrigation, municipal, industrial)			
WELL COMPLETION DATA: (1) diameter (inches) <u>2</u> (2) total depth (feet) <u>415</u> (3) static water level (feet) <u>17</u> below/above top of ground. (4) casing <u>Galv.</u> <u>405</u> (material) (depth) <u>2</u> if telescope see back. (size) (5) screen <u>10'</u> <u>405</u> (length) (depth to top) <u>2</u> <u>S. Steel</u> (size) (material) (6) pump <u>1/2</u> <u>7</u> (HP) (yield gpm) <u>Elec</u> (type power) (7) electric log <u>NO</u> (yes or no) _____ (organization running log) (8) how well bottom plugged <u>B.W. Valve</u>			
DRILLERS REMARKS: _____			

RECEIVED

MAR - 4 1977

If well telescopes please sketch and show depths.

GROUND LEVEL

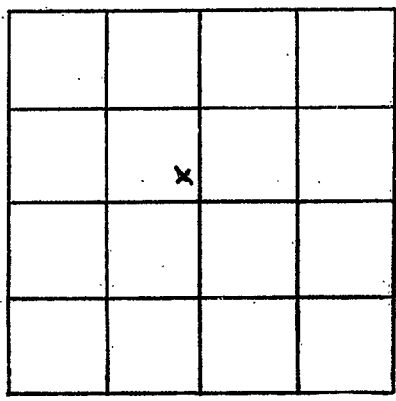

SECTION 7

Please indicate well location X.

ADDITIONAL INFORMATION

Lined area for additional information.

If more than one screen, show locations of each on sketch.