

Pearl River
 7 2081
 3-9-77

MISSISSIPPI
 BOARD OF WATER COMMISSIONERS
 416 North State Street
 Jackson, Mississippi 39201

WATER WELL DRILLERS LOG

3-9 date well completed 1977 ~~Stumpkin Well Co.~~ *Stackstill Bros.* firm name Pearl River county well located

LANDOWNER:
 Sycamore Baptist Church
 Piquette, Miss.
 (mailing address)

description of formations encountered	from to	
Clay	0	15
Sand	15	6.5
Clay	6.5	10.5
fine Sand	10.5	160
Clay	160	190
Sand	190	220
Clay	220	380
Sand	380	420

WELL LOCATION:
 sec. 7 T N R E
 2 6 S East 16 W
 (distance) (direction) (nearest town)
 miles of Piquette

WELL PURPOSE: Home
 (home, irrigation, municipal, industrial)

- WELL COMPLETION DATA:
- (1) diameter (inches) 2"
 - (2) total depth (feet) 420'
 - (3) static water level (feet) 26' below top of ground.
 - (4) casing P.V.C., 410' (material) (depth)
 2" (size) If telescope see back.
 - (5) screen 10', 410' (length) (depth to top)
 2", P.V.C. (size) (material)
 - (6) pump 1/2 (HP) 280 GPH (yield gpm)
 Electric (type power)
 - (7) electric log No (yes or no)

(organization running log)

(8) how well bottom plugged sand sharp


DRILLERS REMARKS:

RECEIVED
 JUN 20 1977

MISS. Bd. OF WATER COMMISSIONERS

If well telescopes please
sketch and show depths.

GROUND LEVEL

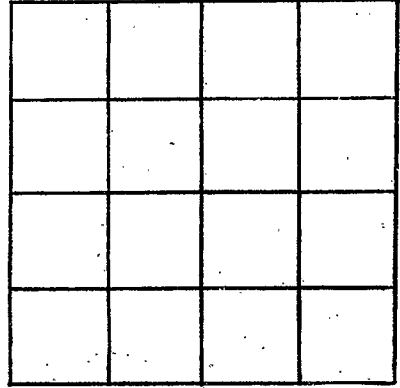

SECTION _____

Please indicate well location X.

ADDITIONAL INFORMATION

Lined area for additional information, consisting of 20 horizontal lines.

If more than one screen,
show locations of each on sketch.