

Pearl River
 1000
 4/15/77

MISSISSIPPI
 BOARD OF WATER COMMISSIONERS
 416 North State Street
 Jackson, Mississippi 39201

WATER WELL DRILLERS LOG

4/15/77 date well completed 19 79 Pearl River & Son Pearl River firm name Pearl River county well located

LANDOWNER: Tony Smith
 Salem Miss.
 R-T. 3 Pascagoula
 (mailing address)

description of formations encountered	from	to
Gray shale	0	10
White sand	10	55

WELL LOCATION:
 sec. 10 T. 6 N R. 16 E
 5 miles East of Pascagoula
 (distance) (direction) (nearest town)

WELL PURPOSE: home
 (home, irrigation, municipal, industrial)

- WELL COMPLETION DATA:
- (1) diameter (inches) 2"
 - (2) total depth (feet) 55 ft
 - (3) static water level (feet) 8 ft below top of ground
 - (4) casing PVC, 45' (material) (depth)
 (size) If telescope see back.
 - (5) screen 2x10, 45 ft (length) (depth to top)
 1/2" PVC (size) (material)
 - (6) pump 1/2 HP, 600 gpm (HP) (yield gpm)
 Elect. (type power)
 - (7) electric log NO (yes or no)

(organization running log)
 (8) how well bottom plugged
 Short sand

DRILLERS REMARKS:


RECEIVED

SEP 13 1977

MISS. Bd. of Water Comm.

If well telescopes please sketch and show depths.

GROUND LEVEL

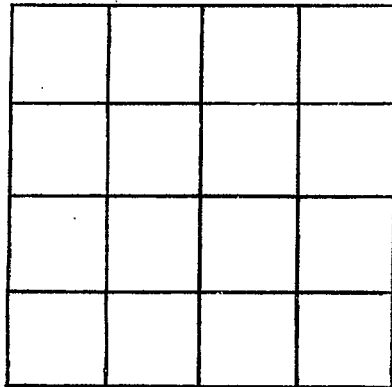

SECTION _____

Please indicate well location X.

ADDITIONAL INFORMATION

A series of horizontal lines for recording additional information.

If more than one screen, show locations of each on sketch.