

Pearl River
 X 2033
 5-12-77

MISSISSIPPI
 BOARD OF WATER COMMISSIONERS
 416 North State Street
 135 Jackson, Mississippi 39201

WATER WELL DRILLERS LOG

5-12-77 date well completed
 Bud Denton & Son firm name
 Pearl River county well located

LANDOWNER: Don Shaw
Rt. 3
 (mailing address)

description of formations encountered	from	to
white shale	0	70
white sand	70	85
blue shale	85	570
gray sand	570	580

WELL LOCATION:
 sec. 10 T. 6 N. R. 16 E.
~~8 1/2~~ ³ miles East of Pearl River
 (distance) (direction) (nearest town)

WELL PURPOSE: home
 (home, irrigation, municipal, industrial)

WELL COMPLETION DATA:
 (1) diameter (inches) 2"
 (2) total depth (feet) 580 ft.
 (3) static water level (feet) 6 ft. below above top of ground.
 (4) casing pvc 570
 (material) (depth)
 (size) if telescope see back.
 (5) screen 2x10 570
 (length) (depth to top)
12 pvc
 (size) (material)
 (6) pump 1/2 600
 (HP) (yield gpm)
Elect
 (type power)
 (7) electric log no
 (yes or no)
 (organization running log)
 (8) how well bottom plugged shut sand

DRILLERS REMARKS:


RECEIVED

SEP 13 1977

MISS. Bd. OF WATER COMMISSIONERS

If well telescopes please sketch and show depths.

GROUND LEVEL

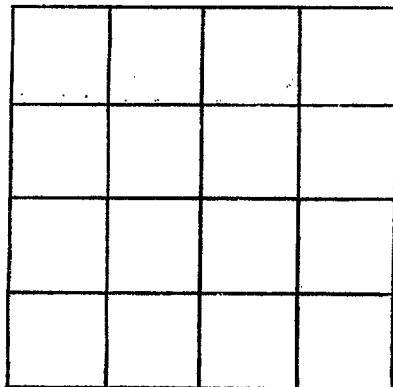

SECTION _____

Please indicate well location X.

ADDITIONAL INFORMATION

A series of horizontal lines for recording additional information.

If more than one screen, show locations of each on sketch.