

Pearl River
X 2034
6-6/77

MISSISSIPPI
 BOARD OF WATER COMMISSIONERS
 416 North State Street
 135 Jackson, Mississippi 39201

WATER WELL DRILLERS LOG

6/6 1977 Bud Taylor & Son Pearl River
 date well completed firm name county well located

LANDOWNER: James Lee
P.O. 3 Piquette Miss
 (mailing address)
 WELL LOCATION:
 sec. 10 T. 6 N. R. 16 E
6 miles East of Piquette
 (distance) (direction) (nearest town)

description of formations encountered	from	to
<u>Grey shale</u>	<u>0</u>	<u>35</u>
<u>white sand</u>	<u>35</u>	<u>76</u>
<u>Blue shale</u>	<u>76</u>	<u>196</u>
<u>Blue sand</u>	<u>196</u>	<u>230</u>

WELL PURPOSE: home
 (home, irrigation, municipal, industrial)

- WELL COMPLETION DATA:
- (1) diameter (inches) 4"
 - (2) total depth (feet) 230
 - (3) static water level (feet) 27 below top of ground.
 - (4) casing pvc, 220
 (material) (depth)
 (size) if telescope see back.
 - (5) screen 4x10, 220
 (length) (depth to top)
12, pvc
 (size) (material)
 - (6) pump 3/4, 1450 gpm
 (HP) (yield gpm)
Elect
 (type power)
 - (7) electric log no
 (yes or no)


(organization running log)
 (8) how well bottom plugged shard

DRILLERS REMARKS:

RECEIVED

If well telescopes please
sketch and show depths.

GROUND LEVEL

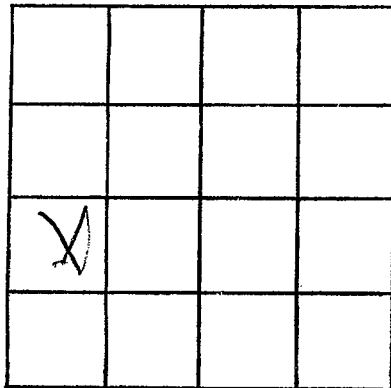

SECTION _____

Please indicate well location X.

ADDITIONAL INFORMATION

Lined area for additional information.

If more than one screen,
show locations of each on sketch.