

Pearl River
 X 2037
 11/17/77

MISSISSIPPI
 BOARD OF WATER COMMISSIONERS
 416 North State Street
 Jackson, Mississippi 39201

WATER WELL DRILLERS LOG

11-17 date well completed 77 Penton Well Serv. firm name Pearl River county well located

LANDOWNER: Preston Spiers
RT
Picayune, MS
 (mailing address)

WELL LOCATION:
 sec. 7 T. 6 S. R. 16 E
1/2 miles East of Picayune
 (distance) (direction) (nearest town)

WELL PURPOSE: Home
 (home, irrigation, municipal, industrial)

- WELL COMPLETION DATA:
- diameter (inches) 2"
 - total depth (feet) 166'
 - static water level (feet) 23' below above top of ground.
 - casing Galv (material), 156' (depth)
2" (size) if telescope see back.
 - screen 10' (length), 156' (depth to top)
2" (size), S. Steel (material)
 - pump 1/2 (HP), 9 (yield gpm)
Elec (type power)
 - electric log no. (yes or no)
 (organization running log)
 - how well bottom plugged bw/dalve


description of formations encountered	from	to
CLAY	0	20
SAND + CLAY	20	46
BLUE CLAY	40	155
SAND	155	166

DRILLERS REMARKS:

RECEIVED
 DEC 27 1977
 MISS. BB. OF WATER COMM

If well telescopes please sketch and show depths.

GROUND LEVEL

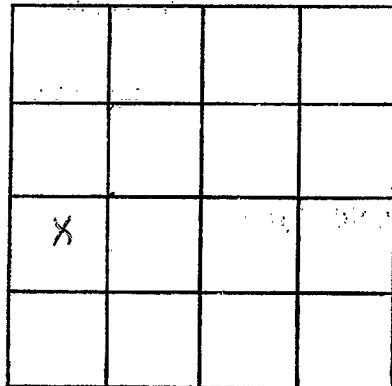

SECTION 7

Please indicate well location X.

ADDITIONAL INFORMATION

A series of horizontal lines for writing additional information.

If more than one screen, show locations of each on sketch.