

Pearl R.
 X 2038
 6/23/77

MISSISSIPPI
 BOARD OF WATER COMMISSIONERS
 416 North State Street
 Jackson, Mississippi 39201

WATER WELL DRILLERS LOG

6-23-77 19 Bud Rute, Son Pearl River
 date well completed firm name county well located

LANDOWNER:
Charles Hobbs
P.O. Box 1000
 (mailing address)

description of formations encountered	from	to
<u>White Shale</u>	<u>0</u>	<u>30</u>
<u>White Sand</u>	<u>30</u>	<u>90</u>
<u>Blue Shale</u>	<u>90</u>	<u>200</u>
<u>Grey Sand</u>	<u>200</u>	<u>453</u>

WELL LOCATION:
 sec. 6 T. 6 N. R. 16 E.
1 1/2 miles NE of Waynes
 (distance) (direction) (nearest town)


WELL PURPOSE: Home
 (home, irrigation, municipal, industrial)

- WELL COMPLETION DATA:
- (1) diameter (inches) 4 1/2
 - (2) total depth (feet) 453
 - (3) static water level (feet) 27 ^{below} above top of ground.
 - (4) casing Galv. 4 3/8
 (material) (depth)
 - _____ if telescope see back.
 (size)
 - (5) screen 2x10 453
 (length) (depth to top)
12 Stainless Steel
 (size) (material)
 - (6) pump 1/2 180
 (HP) (yield gpm)
electric 1290m
 (type power)
 - (7) electric log no
 (yes or no)

(organization running log)

(8) how well bottom plugged
Sand Shale


DRILLERS REMARKS:

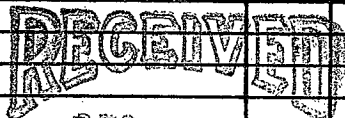

DEC 30 1977

If well telescopes please sketch and show depths.

GROUND LEVEL

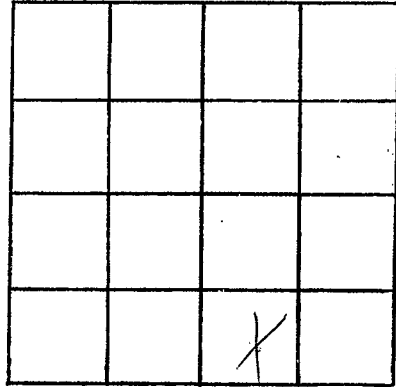

SECTION _____

Please indicate well location X.

ADDITIONAL INFORMATION

A series of horizontal lines for writing additional information.

If more than one screen, show locations of each on sketch.