

Pearl River  
20037  
7-1-77

MISSISSIPPI  
 BOARD OF WATER COMMISSIONERS  
 416 North State Street  
 Jackson, Mississippi 39201

WATER WELL DRILLERS LOG

7-1 1977 PENTON Well Serv. PEARL River  
 date well completed firm name county well located

LANDOWNER: Troy Spiels  
Picayune MISS  
 (mailing address)  
 WELL LOCATION:  
 sec. 7 T 6 N R 16 E  
 S W  
1/2 miles East of Picayune  
 (distance) (direction) (nearest town)

description of formations encountered	from	to
Surface Clay	0	25
SAND	25	35
Blue Clay	35	75
SILT	75	95
Blue Clay	95	150
SAND	150	167

WELL PURPOSE: Home  
 (home, irrigation, municipal, industrial)

WELL COMPLETION DATA:  
 (1) diameter (inches) 2  
 (2) total depth (feet) 167  
 (3) static water level (feet) 23 below above top of ground.  
 (4) casing Galv. 157  
 (material) (depth)  
2 if telescope see back.  
 (size)  
 (5) screen 10 157  
 (length) (depth to top)  
2 S. Steel  
 (size) (material)  
 (6) pump 3/4 12  
 (HP) (yield gpm)  
Elec  
 (type power)  
 (7) electric log NO  
 (yes or no)  
 (organization running log)  
 (8) how well bottom plugged Blw. Valve


**RECEIVED**  
 AUG 1 1977

DRILLERS REMARKS:

MISS. BD. OF WATER COMMISSIONERS

If well telescopes please sketch and show depths.

GROUND LEVEL

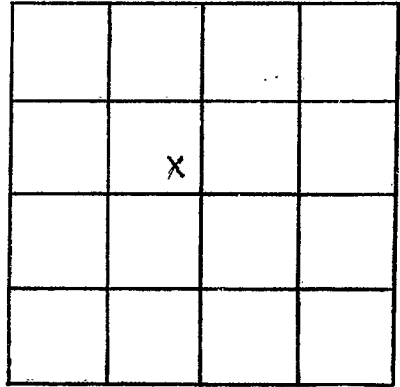

SECTION 7

Please indicate well location X.

ADDITIONAL INFORMATION

A series of 20 horizontal lines for writing additional information.

If more than one screen, show locations of each on sketch.