

PEARL RIVER

X 2044

MISSISSIPPI BOARD OF WATER COMMISSIONERS
416 North State Street
Jackson, Mississippi 39201

WATER WELL DRILLERS LOG
POUNCEY WATER WELL DRILLING

Paul Rennie

6-21 1978 date well completed

Pouncey firm name

county well located

LANDOWNER: *Fallon Risinger*

Sycamore Rfd.

Pouncey MS.
(mailing address)

WELL LOCATION:

sec 18 T 10 N R 16 E
S W
3 miles NE of Pouncey
(distance) (direction) (nearest town)

WELL PURPOSE: None
(home, irrigation, municipal, industrial)

WELL COMPLETION DATA:

- (1) diameter (inches) 2
- (2) total depth (feet) 413
- (3) static water level (feet) 216 below top of ground.
- (4) casing PVC 403
(material) (depth)
- 2 If telescope see back.
(size)
- (5) screen 10 403
(length) (depth to top)
- 2 PVC
(size) (material)
- (6) pump 1 12
(HP) (yield gpm)
- AC
(type power)
- (7) electric log 1
(yes or no)
- (organization running log)
- (8) how well bottom plugged 1

description of formations encountered

from

to

St. clay stratum

0 96

clay str.

96 145

sd

145 160

clay

160 330

fine sd

330 352

sd good.

352 368

fine

368 384

fine

384 400

fine to good sd

400 413

RECEIVED


AUG - 1 1978

DRILLERS REMARKS:

MISS. BD. OF WATER COMMISSIONERS

If well telescopes please
sketch and show depths.

GROUND LEVEL

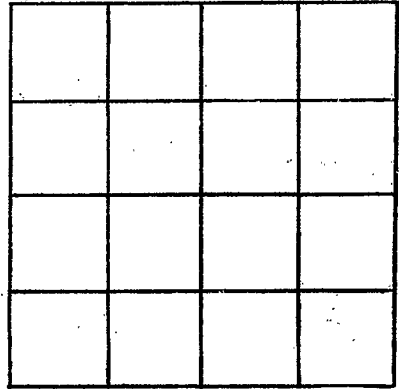

SECTION _____

Please indicate well location X.

ADDITIONAL INFORMATION

If more than one screen,
show locations of each on sketch.