

PEARL RIVER
 X 2013
 8-25578

MISSISSIPPI
 BOARD OF WATER COMMISSIONERS
 416 North State Street
 Jackson, Mississippi 39201

WATER WELL DRILLERS LOG PEARL RIVER CO.


8-25-19 78 Woid Well Old Hammer
 date well completed firm name county well located

LANDOWNER: A. Hunt
General Delivery
Rearlington Miss
 (mailing address)
 WELL LOCATION:
 sec. 17 T. 6 N. R. 16 E. W.
3
 miles of Rearlington
 (distance) (direction) (nearest town)

description of formations encountered	from	to
<u>top Soil-clay</u>	<u>0</u>	<u>21</u>
<u>sd</u>	<u>21</u>	<u>36</u>
<u>Clay</u>	<u>36</u>	<u>75</u>
<u>sd</u>	<u>35</u>	<u>96</u>
<u>Clay</u>	<u>96</u>	<u>110</u>
<u>Coast sd</u>	<u>110</u>	<u>125</u>

WELL PURPOSE: Home
 (home, irrigation, municipal, industrial)

WELL COMPLETION DATA:
 (1) diameter (inches) 2"
 (2) total depth (feet) 125
 (3) static water level (feet) 9 below above
 top of ground.
 (4) casing PVC, 120,
 (material) (depth)
 (size) If telescope see back.
 (5) screen 5' -
 (length) (depth to top)
2" PVC
 (size) (material)
 (6) pump owner
 (HP) (yield gpm)
 (type power)
 (7) electric log NO
 (yes or no)
N/A
 (organization running log)
 (8) how well bottom plugged BWV

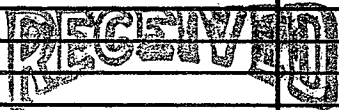


SEP 21 1970

DRILLERS REMARKS: N/A

MISS. BD. OF WATER COMMISSIONERS

If well telescopes please sketch and show depths.

GROUND LEVEL

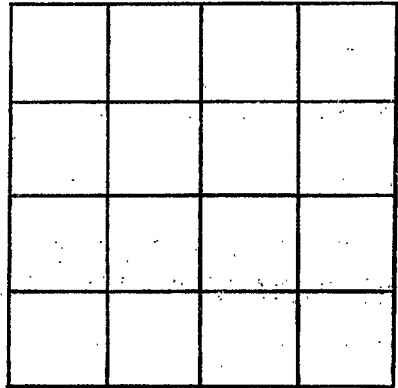

SECTION 17

Please indicate well location X.

ADDITIONAL INFORMATION

If more than one screen, show locations of each on sketch.