

PEARL RIVER
 X 2015
 10-16-78

MISSISSIPPI
 BOARD OF WATER COMMISSIONERS
 416 North State Street
 Jackson, Mississippi 39201

WATER WELL DRILLERS LOG

10/16/78 date well completed 1978 Paul Denton & Son firm name Pearl River county well located


LANDOWNER:	description of formations encountered	from	to
James Truckner	Red shale	0	70
PO Box	White sand	70	110
	Blue shale	110	205
	Blue sand	205	243

(mailing address)
 WELL LOCATION:
 sec. 12 T. 6 N. R. 16 E.
 4 miles East of Osprey
 (distance) (direction) (nearest town)

WELL PURPOSE: Home
 (home, irrigation, municipal, industrial)

- WELL COMPLETION DATA:
- (1) diameter (inches) 4
 - (2) total depth (feet) 243
 - (3) static water level (feet) 23 below top of ground.
 - (4) casing PVC, 233 (material), (depth)
 no (size) if telescope see back.
 - (5) screen 4x10, 233 (length), (depth to top)
 12, PVC (size), (material)
 - (6) pump 1, 1650 (HP), (yield gpm)
 Elect. (type power) 9pt
 - (7) electric log no (yes or no)
 no (organization running log)
 - (8) how well bottom plugged Sand shank

DRILLERS REMARKS:

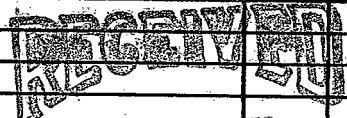

JAN 26 1978

If well telescopes please sketch and show depths.

GROUND LEVEL

			X

SECTION _____

Please indicate well location X.

ADDITIONAL INFORMATION

If more than one screen, show locations of each on sketch.