

PEARL RIVER

X 2000

10-13-78

MISSISSIPPI
BOARD OF WATER COMMISSIONERS
416 North State Street
Jackson, Mississippi 39201

WATER WELL DRILLERS LOG

10-13
date well completed

1978 Periton Well Serv
firm name

Pearl River
county well located

LANDOWNER: Spiers Bros -

Rr.

Carriere, MS.
(mailing address)

WELL LOCATION:

sec. 7 T. 6 R. 16
S W
1/2 miles NE E of Aczyune
(distance) (direction) (nearest town)

WELL PURPOSE: Home
(home, irrigation, municipal, industrial)

WELL COMPLETION DATA:

- (1) diameter (inches) 2"
- (2) total depth (feet) 429'
- (3) static water level (feet) 34' below above top of ground.
- (4) casing Galv. 419'
(material) (depth)
- 2"
(size) if telescope see back.
- (5) screen 10' 419'
(length) (depth to top)
- 2" S. Steel
(size) (material)
- (6) pump 1 10
(HP) (yield gpm)
- Elec
(type power)
- (7) electric log NO
(yes or no)

(organization running log)


(8) how well bottom plugged B.W. Value

DRILLERS REMARKS:

description of formations encountered

from to

Surface Clay	0	20
Sand	20	35
Blue Clay	35	180
Sand	180	215
Blue Clay	215	360
Sand	360	429

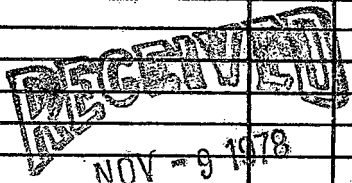

MISS. BD. OF WATER COMMISSIONERS

