

Pearl River  
X 2048

MISSISSIPPI  
BOARD OF WATER COMMISSIONERS  
416 North State Street  
Jackson, Mississippi 39201

X

9-3-79

WATER WELL DRILLERS LOG

9-3-79  
date well completed

19 Penton Well Serv  
firm name

Pearl River  
county well located

LANDOWNER: Robert Sampson

description of formations encountered	from	to
	Surface Clay	0
Sand	15	60
Blue Clay	60	540
Sand	540	690

Rt-

Picayune Ms.  
(mailing address)

WELL LOCATION:

sec. 16 T. 6 N. R. 16 W. S. W.  
3 miles East of Picayune  
(distance) (direction) (nearest town)

WELL PURPOSE: Home  
(home, irrigation, municipal, industrial)

WELL COMPLETION DATA:


- (1) diameter (inches) 2"
- (2) total depth (feet) 690'
- (3) static water level (feet) 9' below top of ground
- (4) casing Galv (material), 680' (depth)  
2" (size) if telescope see back.
- (5) screen 10' (length), 680' (depth to top)  
2" (size), S. Steel (material)
- (6) pump 1/2 (HP), 8 (yield gpm)  
Elec (type power)
- (7) electric log No (yes or no)  
(organization running log)
- (8) how well bottom plugged BW valve

Rec'd 10-2-79

DRILLERS REMARKS:

If well telescopes please sketch and show depths.

GROUND LEVEL

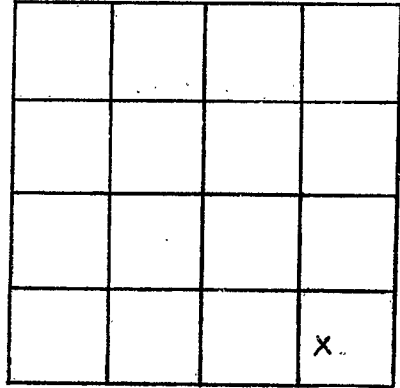

SECTION 16

Please indicate well location X.

ADDITIONAL INFORMATION

A series of horizontal lines for writing additional information.

If more than one screen, show locations of each on sketch.