

Pearl River  
 X 2050  
 5/23/80

MISSISSIPPI  
 BOARD OF WATER COMMISSIONERS  
 416 North State Street  
 Jackson, Mississippi 39201

WATER WELL DRILLERS LOG

1/3 1980 Bud Porter Water Well Pearl River  
 date well completed firm name county well located

LANDOWNER: Egera Smith  
 B.T.3 Picayune  
 Miss.  
 (mailing address)

WELL LOCATION:  
 sec. 10 T-6 N R 16 E  
 6 miles East of Picayune  
 (distance) (direction) (nearest town)

WELL PURPOSE: none  
 (home, irrigation, municipal, industrial)

WELL COMPLETION DATA:  
 (1) diameter (inches) 4"  
 (2) total depth (feet) 604  
 (3) static water level (feet) 26 below  
 top of ground.  
 (4) casing PVC, 604,  
 (material) (depth)  
 (size) if telescope see back.  
 (5) screen 15', 589  
 (length) (depth to top)  
 12' (material)  
 (6) pump 1 1/2 HP, 1750  
 (HP) (yield gpm)  
 Elect (type power)  
 (7) electric log NO  
 (yes or no)

(organization running log)  
 (8) how well bottom plugged  
 Sph sand  
 Sph h

DRILLERS REMARKS:

description of formations encountered	from	to
Red shale	0	12
Red sand	12	35
Blue shale	35	150
Red sand	150	175
Blue shale	175	555
gray sand	555	604


DEPT. OF NATURAL RESOURCES  
 BUREAU OF LAND & WATER RESOURCES

MAY 19 1980

RECEIVED

If well telescopes please sketch and show depths.

GROUND LEVEL

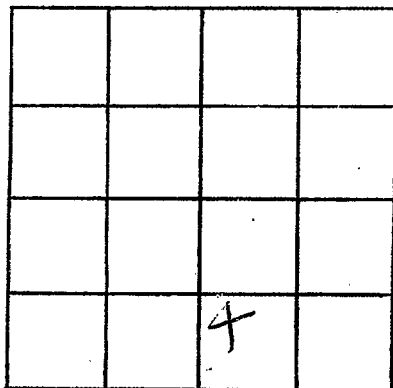

SECTION \_\_\_\_\_

Please indicate well location X.

ADDITIONAL INFORMATION

A series of horizontal lines for recording additional information.

If more than one screen, show locations of each on sketch.