

MISSISSIPPI DEPARTMENT OF NATURAL RESOURCES
Bureau of Land and Water Resources
 Southport Mall
 P.O. Box 10631
 Jackson, Mississippi 39209
WATER WELL DRILLERS LOG

Pearl River
K2050
12-3-80

12-3 1980 Penton Well Serv Pearl River
 date well completed firm name county well located

LANDOWNER: <u>Troy Spiers</u>	description of formations encountered	from	to
<u>Picayune, MS</u> (mailing address)	<u>Surface Clay</u>	<u>0</u>	<u>20</u>
	<u>Sand</u>	<u>20</u>	<u>42</u>
	<u>Blue Clay</u>	<u>42</u>	<u>210</u>
	<u>Sand</u>	<u>210</u>	<u>230</u>
WELL LOCATION:	<u>Blue Clay</u>	<u>230</u>	<u>400</u>
sec. <u>7</u> T. <u>6</u> M. R. <u>16</u> W.	<u>Silt</u>	<u>400</u>	<u>430</u>
<u>1/2</u> miles <u>East</u> of <u>Picayune</u>	<u>Blue Clay</u>	<u>430</u>	<u>650</u>
(distance) (direction) (nearest town)	<u>Silt</u>	<u>650</u>	<u>685</u>
WELL PURPOSE: <u>name</u>	<u>Blue Clay</u>	<u>685</u>	<u>740</u>
(home, irrigation, municipal, industrial)	<u>Sand</u>	<u>740</u>	<u>761</u>
WELL COMPLETION DATA:			
(1) diameter (inches) <u>2"</u>			
(2) total depth (feet) <u>761'</u>			
(3) static water level (feet) <u>1'</u> below above top of ground.			
(4) casing <u>Galv</u> , <u>751'</u>			
(material) (depth)			
<u>2"</u> If telescope see back.			
(size)			
(5) screen <u>10'</u> , <u>751'</u>			
(length) (depth to top)			
<u>2"</u> , <u>S. Steel</u>			
(size) (material)			
(6) pump <u>3/4</u> , <u>17</u>			
(HP) (yield gpm)			
<u>Elec</u>			
(type power)			
(7) electric log <u>No</u>			
(yes or no)			
(organization running log)			
(8) how well bottom plugged <u>Bw Valve</u>			
DRILLERS REMARKS:			


DEPT. OF NATURAL RESOURCES
 BUREAU OF LAND & WATER RESOURCES

DEC 15 1980

RECEIVED

If well telescopes please sketch and show depths.

GROUND LEVEL

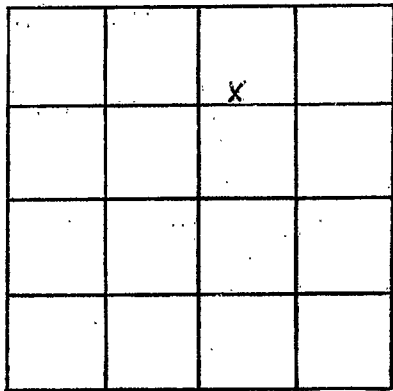

SECTION 7

Please indicate well location X.

ADDITIONAL INFORMATION

If more than one screen,
show locations of each on sketch.