

PEARL RIVER  
X 2058

MISSISSIPPI  
BOARD OF WATER COMMISSIONERS  
416 North State Street  
Jackson, Mississippi 39201

3

WATER WELL DRILLERS LOG

1/14/81  
1/14

date well completed

81 Bud Penton  
Water Well Driller

firm name

Pearl River

county well located

LANDOWNER:

Charles Carnahan

description of formations encountered

from

to

R.T. 1 PO Box  
Pineyville Miss.  
(mailing address)

Red Shale  
Blue Shale  
Blue Sand

0 40  
40 520  
520 375

WELL LOCATION:

sec. 10 T. 6 N R. 16 E  
S W  
6 miles East of Pineyville  
(distance) (direction) (nearest town)

WELL PURPOSE:

home  
(home, irrigation, municipal, industrial)

WELL COMPLETION DATA:

- (1) diameter (inches) 2"
- (2) total depth (feet) 375
- (3) static water level (feet) 20 below top of ground.
- (4) casing PVC 375 (material) (depth)  
no if telescope see back. (size)
- (5) screen 2x10 365 (length) (depth to top)  
10 PVC (size) (material)
- (6) pump 1 960 W (HP) (yield gpm)  
Electric (type power)
- (7) electric log no (yes or no)
- (organization running log)
- (8) how well bottom plugged

DRILLERS REMARKS:


Sand  
Short

DEPT. OF NATURAL RESOURCES  
BUREAU OF LAND & WATER RESOURCES

RECEIVED  
FEB 19 1981

If well telescopes please sketch and show depths.

GROUND LEVEL

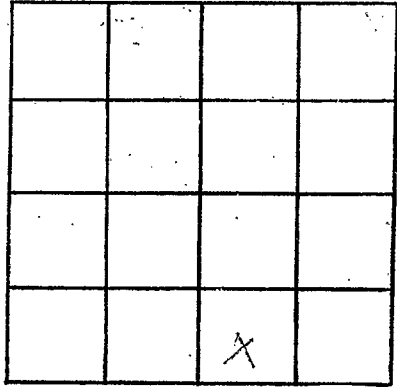

SECTION \_\_\_\_\_

Please indicate well location X.

ADDITIONAL INFORMATION

A series of horizontal lines for recording additional information.

If more than one screen, show locations of each on sketch.