


PEARL RIVER  
 X 2059  
 3-4-81

MISSISSIPPI  
 BOARD OF WATER COMMISSIONERS  
 416 North State Street  
 Jackson, Mississippi 39201

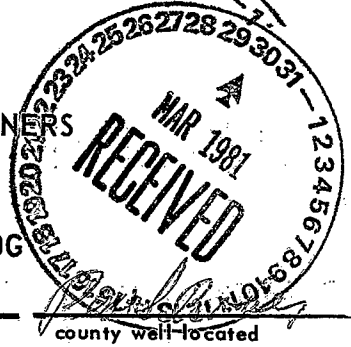

WATER WELL DRILLERS LOG

3/14 1981 date well completed  
 81 Bud Penton firm name  
 Water Well Services county well-located

LANDOWNER: Danny Whitehead  
 P.O. Box 4 Picayune  
 Miss.  
 (mailing address)

description of formations encountered	from	to
Red shale	0	22
<del>White shale</del>	22	60
White sand		
Blue shale	60	125
Gray sand	180	222

WELL LOCATION:  
 ? sec. 21 T. 6 N R. 15 E  
 S W  
 2.8 miles East of Picayune  
 (distance) (direction) (nearest town)

WELL PURPOSE: home  
 (home, irrigation, municipal, industrial)


WELL COMPLETION DATA:

- diameter (inches) 4"
- total depth (feet) 222
- static water level (feet) 41 below above top of ground.
- casing PVC, 222  
 (material) (depth)  
 (size) if telescope see back.
- screen 4x10, 212  
 (length) (depth to top)  
12, PVC  
 (size) (material)
- pump 1, 1360  
 (HP) (yield-gpm) M  
Elect  
 (type power)
- electric log no  
 (yes or no)
- organization running log
- how well bottom plugged hard  
shark

DRILLERS REMARKS:

If well telescopes please sketch and show depths.

GROUND LEVEL

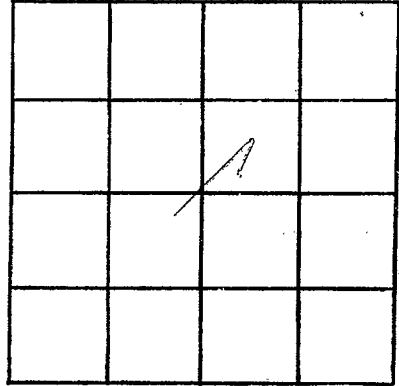

SECTION \_\_\_\_\_

Please indicate well location X.

ADDITIONAL INFORMATION

If more than one screen, show locations of each on sketch.