

PEARL RIVER
 X 2000
 3-12-81

MISSISSIPPI
 BOARD OF WATER COMMISSIONERS
 416 North State Street
 Jackson, Mississippi 39201



WATER WELL DRILLERS LOG

date well completed 3/17 19 81 Bud Patton firm name
Water Well Service county well located Pearl River

LANDOWNER: Ray W. Patton
R.T. C. Botwin
Picoyuro Miss.
 (mailing address)

description of formations encountered	from to	
<u>Red shale</u>	<u>0</u>	<u>21</u>
<u>White sand</u>	<u>21</u>	<u>60</u>
<u>Blue shale</u>	<u>60</u>	<u>300</u>
<u>Gray sand</u>	<u>300</u>	<u>360</u>

WELL LOCATION:
 ? sec. 7 T. 20 N. R. 13 E
4 1/2 miles East of Salisbury
 (distance) (direction) (nearest town)

WELL PURPOSE: home
 (home, irrigation, municipal, industrial)

- WELL COMPLETION DATA:
- (1) diameter (inches) 2"
 - (2) total depth (feet) 350
 - (3) static water level (feet) 22 below top of ground.
 - (4) casing PVC 360
 (material) (depth)
 (size) if telescope see back.
 - (5) screen 10 340
 (length) (depth to top)
12 PVC
 (size) (material)
 - (6) pump 1/2 460
 (HP) (yield gpm) 1
Elect
 (type power)
 - (7) electric log no
 (yes or no)


(organization running log)

(8) how well bottom plugged hard

DRILLERS REMARKS:

If well telescopes please sketch and show depths.

GROUND LEVEL

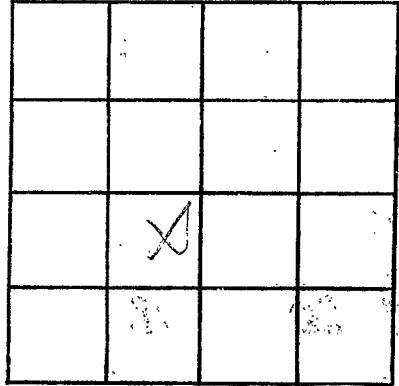

SECTION _____

Please indicate well location X.

ADDITIONAL INFORMATION

Lined area for additional information.

If more than one screen, show locations of each on sketch.