

MISSISSIPPI DEPARTMENT OF NATURAL RESOURCES

Bureau of Land and Water Resources

Southport Mall

P.O. Box 10631

Jackson, Mississippi 39209

WATER WELL DRILLERS LOG

PEARL RIVER
X 2002
4/28/81

4/28/81 1981 James Whitaker Pearl River
 date well completed well name county well located

LANDOWNER: Derwin Bales

description of formations encountered

from to

(mailing address)

WELL LOCATION:

sec. 17 T. 6 N R. 16 E
4 miles E Greystone
 (distance) (direction) (nearest town)

Top soils clay 0 8
good shallow sand 8 48
Very big on bottom

WELL PURPOSE:
 (home, irrigation, municipal, industrial)

WELL COMPLETION DATA:

- (1) diameter (inches) 2
- (2) total depth (feet) 48
- (3) static water level (feet) 4 below above top of ground.
- (4) casing PVC (material) (depth) if telescope see back. (size)
- (5) screen 10 (length) 38 (depth to top) (size) (material)
- (6) pump (2) two 1/2 HP shallow (HP) one unit have one (yield gpm) (type power) unit ?
- (7) electric log (yes or no) (organization running log)
- (8) how well bottom plugged no

DEPT. OF NATURAL RESOURCES
 BUREAU OF LAND & WATER RESOURCES


MAY 19 1981

RECEIVED

DRILLERS REMARKS:

If well telescopes please
sketch and show depths.

GROUND LEVEL

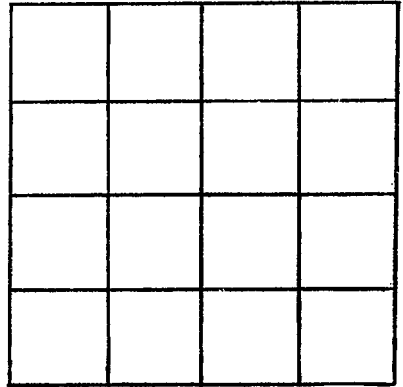

SECTION _____

Please indicate well location X.

ADDITIONAL INFORMATION

If more than one screen,
show locations of each on sketch.