

MISSISSIPPI DEPARTMENT OF NATURAL RESOURCES

BUD PENNELL, State Land and Water Resources
 WATER WELL SERVICE
 ROUTE 3 BOX 41 Southport Mall
 CARRIERE, MS 39426 P.O. Box 10631
 PHONE 798-5324

Jackson, Mississippi 39209

BUD PENNELL DRILLERS LOG

WATER WELL SERVICE
 ROUTE 3 BOX 41
 CARRIERE, MS 39426
 PHONE 798-5324

Pearl River
X 2004
8/27/81

8/27 1981
 date well completed

Pearl River
 county well located

LANDOWNER: Norman
Macinnis,
Macinnis B.T.3
Box 293 B Carriere
 (mailing address)

description of formations encountered

from to

<u>Blue Shale</u>	<u>0</u>	<u>65</u>
<u>White Sand</u>	<u>65</u>	<u>82</u>
<u>Blue Shale</u>	<u>82</u>	<u>350</u>
<u>Blue Sand</u>	<u>350</u>	<u>390</u>

WELL LOCATION:

sec. 10 T. 6 N. R. 16 E.
3 miles East of Prague
 (distance) (direction) (nearest town)

WELL PURPOSE: Home
 (home, irrigation, municipal, industrial)

WELL COMPLETION DATA:

- (1) diameter (inches) 2"
- (2) total depth (feet) 390
- (3) static water level (feet) 21 below above top of ground.
- (4) casing pvc, 390,
 (material) (depth)
- (size) if telescope see back.
- (5) screen 2x10, 380
 (length) (depth to top)
- (size) (material)
- (6) pump 1/2, 450
 (HP) (yield gpm)
- (type power) Elect.
- (7) electric log no
 (yes or no)

(organization running log)

- (8) how well bottom plugged good

DRILLERS REMARKS: Short


DEPT. OF NATURAL RESOURCES
 BUREAU OF LAND & WATER RESOURCES

SEP 29 1981

RECEIVED

If well telescopes please sketch and show depths.

GROUND LEVEL

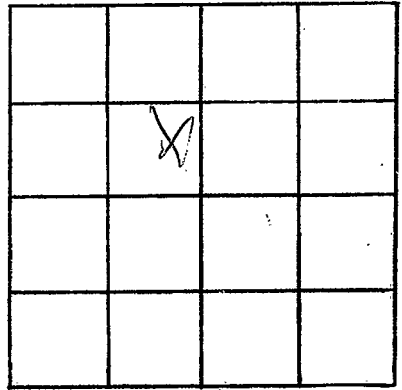

SECTION _____

Please indicate well location X.

ADDITIONAL INFORMATION

If more than one screen, show locations of each on sketch.