

MISSISSIPPI DEPARTMENT OF NATURAL RESOURCES

Bureau of Land and Water Resources

Southport Mall

P.O. Box 10631

Jackson, Mississippi 39209

WATER WELL DRILLERS LOG

Pearl River
K 2065
7-14-81

7-14 date well completed

POUNCEY WATER WELL DRILLING

firm name

PEARL RIVER county well located

LANDOWNER: MR. William Tate

description of formations encountered

from

to

R/3 Picayune

TOP - 0 10

MS, 79466 (mailing address)

SD - dry - 10 32

WELL LOCATION:

sec. 17 T 6 N R 16 E
3 miles E of Picayune (distance) (direction) (nearest town)

clay hd. 32 36

gumbo clay - 36 40

WELL PURPOSE: home (home, irrigation, municipal, industrial)

clay - 40 160

slt. 160 188

WELL COMPLETION DATA:

(1) diameter (inches) 2
(2) total depth (feet) 740
(3) static water level (feet) 1 (below/above top of ground)

Clay - 188 230

Clay Hd Hd - 230 270

(4) casing PVC 730 (material) (depth)

Clay - 270 285

sd. fine (putty) 285 300

(5) screen 2 730 (size) (length) (depth to top)

Hd Hd Clay streaks 300 365

7 Rock w/ lime streaks
slt. int. fine sd. 365 420

(6) pump 1/2 10 (HP) (yield gpm)

Hd Clay - 420 422

sd. 422 424

(7) electric log AC 220V (type power)

Hd Clay - 424 490

slt. some Hd. 490 680

(8) how well bottom plugged

sd. 680 740

Sealed.

DEPT. OF NATURAL RESOURCES
BUREAU OF LAND & WATER RESOURCES

DRILLERS REMARKS: 10-32 ft


SEP 18 1981

SD, dry -

RECEIVED

If well telescopes please sketch and show depths.

GROUND LEVEL

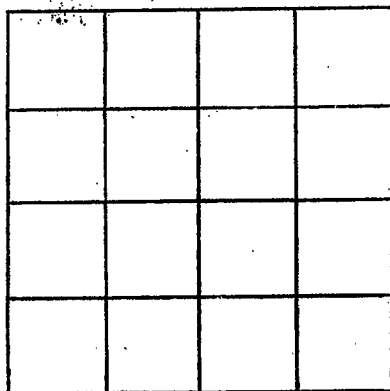

SECTION _____

Please indicate well location X.

ADDITIONAL INFORMATION

If more than one screen,
show locations of each on sketch.