

MISSISSIPPI DEPARTMENT OF NATURAL RESOURCES

Bureau of Land and Water Resources

Southport Mall

P.O. Box 10631

Jackson, Mississippi 39209

WATER WELL DRILLERS LOG

BOUNCEY WATER WELL DRILLING Pearl River

Pearl River
K 2000
7-20-81

7-20 1981

firm name

county well located

LANDOWNER: MR. William Tate

description of formations encountered

from

to

R3.

PICAYUNE, MS 39466
(mailing address)

Top

0 8

sd-Bigger Bottom 8 45

WELL LOCATION:

sec. 17 T 6 N R 16 E
3 miles E of Picayune
(distance) (direction) (nearest town)

WELL PURPOSE: AC Heat
(home, irrigation, municipal, industrial)

WELL COMPLETION DATA:

- (1) diameter (inches) 2
- (2) total depth (feet) 45
- (3) static water level (feet) 4 below top of ground
- (4) casing PVC 35 (material) (depth)
2 (size) if telescope see back.
- (5) screen 10 35 (length) (depth to top)
2 PVC (size) (material)
- (6) pump 3/4 10 (HP) (yield gpm)
AC 220 (type power)
- (7) electric log (yes or no)
- (organization running log)
- (8) how well bottom plugged Solid.


DEPT. OF NATURAL RESOURCES
BUREAU OF LAND & WATER RESOURCES

SEP 18 1981
RECEIVED

DRILLERS REMARKS: WL-4ft

If well telescopes please sketch and show depths.

GROUND LEVEL

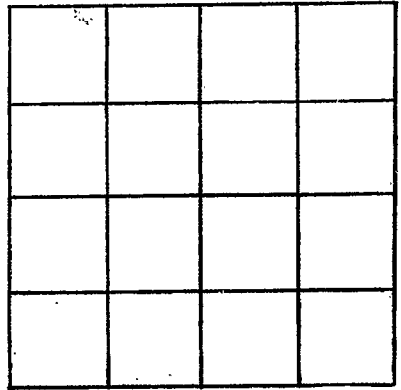

SECTION _____

Please indicate well location X.

ADDITIONAL INFORMATION

If more than one screen,
show locations of each on sketch.