

MISSISSIPPI DEPARTMENT OF NATURAL RESOURCES

Bureau of Land and Water Resources

Southport Mall

P.O. Box 10631

Jackson, Mississippi 39209

WATER WELL DRILLERS LOG

Pearl River
X 2067
7-29-81

BOUNCY WATER WELL DRILLING

Pearl River

7-29 1981
 date well completed

firm name

county well located

LANDOWNER:

Dwain Whitfield

description of formations encountered

from

to

Pl. 3

Picayune, MS 39464
 (mailing address)

Top
SD - used for
fill - tried a
shallow well -
wouldn't clean
up - clay -
SD - good
SD - Lost Kelly

0 12
12 26
26 190
190 240

WELL LOCATION:

sec. 18 T 4 N R. 16 E
1/2 miles E of Picayune
 (distance) (direction) (nearest town)

WELL PURPOSE:
 (home, irrigation, municipal, industrial)

Home

WELL COMPLETION DATA:

- (1) diameter (inches) 2
- (2) total depth (feet) 240
- (3) static water level (feet) 18 below above top of ground.
- (4) casing PVC 230
 (material) (depth)
2
 (size) if telescope see back.
- (5) screen 5 235
 (length) (depth to top)
2 PVC
 (size) (material)
- (6) pump 1/2 9
 (HP) (yield gpm)
200V AC
 (type power)
- (7) electric log _____
 (yes or no)
- _____ (organization running log)
- (8) how well bottom plugged _____

DEPT. OF NATURAL RESOURCES
 BUREAU OF LAND & WATER RESOURCES

SEP 18 1981


RECEIVED

DRILLERS REMARKS:

good free
well pump is a
4" hp. suction shallow
well

If well telescopes please sketch and show depths.

GROUND LEVEL

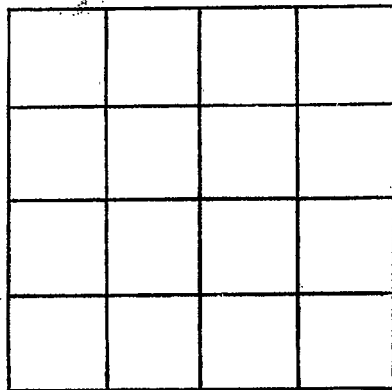

SECTION _____

Please indicate well location X.

ADDITIONAL INFORMATION

If more than one screen,
show locations of each on sketch.