

MISSISSIPPI DEPARTMENT OF NATURAL RESOURCES

Bureau of Land and Water Resources

Southport Mall

P.O. Box 10631

Jackson, Mississippi 39209

WATER WELL DRILLERS LOG

Pearl River
 X 2068
 10-5-81

19-5 1981 date well completed Bud Pate & Son firm name P.R. county well located

LANDOWNER: C.O. Bryant
Salem Ms.
 (mailing address)

WELL LOCATION:
 sec. 16 T. 6 N. R. 16 E
3 1/2 miles E of Union
 (distance) (direction) (nearest town)

WELL PURPOSE: home
 (home, irrigation, municipal, industrial)

WELL COMPLETION DATA:

(1) diameter (inches) 2

(2) total depth (feet) 600

(3) static water level (feet) 2 below top of ground (above)

(4) casing PVC 580
 (material) (depth)

if telescope see back.
 (size)

(5) screen 16' 580
 (length) (depth to top)

2 PVC
 (size) (material)

(6) pump 3/4 130 gpm
 (HP) (yield gpm)

(type power)

(7) electric log (yes or no)

(organization running log)

(8) how well bottom plugged good


description of formations encountered	from	to
grey shale	0	16
Blue shale	20	120
grey sand	120	155
Blue shale	155	280
grey sand	280	365
Blue shale	365	420
Blue sand	420	600

DRILLERS REMARKS:

DEPT. OF NATURAL RESOURCES
 BUREAU OF LAND & WATER RESOURCES
 NOV 9 - 1981
 RECEIVED

If well telescopes please
sketch and show depths.

GROUND LEVEL

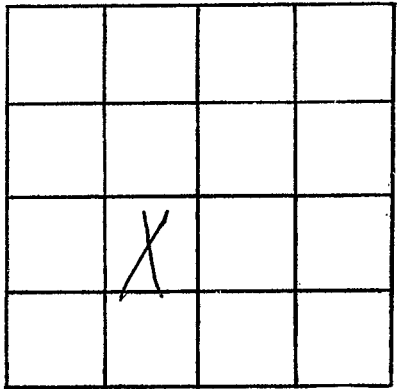

SECTION _____

Please indicate well location X.

ADDITIONAL INFORMATION

If more than one screen,
show locations of each on sketch.