

MISSISSIPPI DEPARTMENT OF NATURAL RESOURCES

Bureau of Land and Water Resources

Southport Mall

P.O. Box 10631

Jackson, Mississippi 39209

WATER WELL DRILLERS LOG

Pearl River
X 2070
10-25-81

10-25 1981 date well completed
Burl Penton & Son firm name
P.R. county well located

LANDOWNER: Roy Walsh
Sycamore Ms.
(mailing address)

description of formations encountered	from	to
gray shale	0	20
white sand	20	110
blue shale	110	280
blue sand	280	290

WELL LOCATION:
sec. 2 T. 6 N. R. 16 E
2 miles E of Sycamore
(distance) (direction) (nearest town)

WELL PURPOSE: Home
(home, irrigation, municipal, industrial)

WELL COMPLETION DATA:

- (1) diameter (inches) 2
- (2) total depth (feet) 290
- (3) static water level (feet) 30 below top of ground.
- (4) casing PVC 280 (material) (depth)
- (size) if telescope see back.
- (5) screen 10' 280 (length) (depth to top)
- (size) PVC (material)
- (6) pump 1/2 6000 (HP) (yield gpm)
- (type power)
- (7) electric log (yes or no)
- (organization running log)
- (8) how well bottom plugged Seal (initials)

DRILLERS REMARKS:


DEPT. OF NATURAL RESOURCES
BUREAU OF LAND & WATER RESOURCES

NOV 9 - 1981

RECEIVED

If well telescopes please sketch and show depths.

GROUND LEVEL

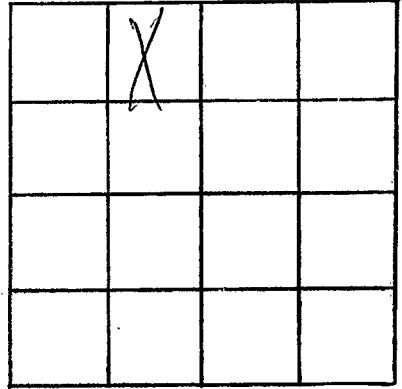

SECTION _____

Please indicate well location X.

ADDITIONAL INFORMATION

If more than one screen,
show locations of each on sketch.